

2146

Survey For:
MEDFORD WATER COMMISSION
Located in Sec. 22, T.37S., R.2W., W.M.
By: Mark E. Boyden
March, 1963

E.N.E. Cor. D.L.C. No. 68

Removed iron pin

N89°52'E
100.00

S 0°05'30"E
638.60

120.00

680.13

560.13

S 0°05'30"E

S 0°05'30"E


Stone with "x"
S.E. Cor. D.L.C. No. 68

N 0°05'30"W

460.06

N45°05'30"W
141.42

Removed iron pin

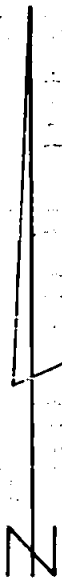

SCALE: 1" = 100'

- Fd. 5/8" iron pin
- Set 5/8" iron pin


NOTE: See Recorded Survey No. 2114

REGISTERED
OREGON
LAND SURVEYOR

Mark E. Boyden

NOVEMBER 9, 1961
MARK E. BOYDEN

281

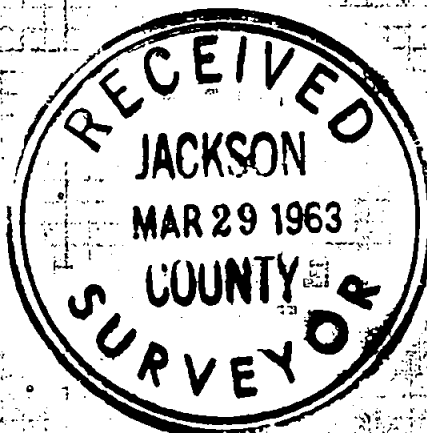

2146

2146

Survey No. 2146

SURVEY NARRATIVE TO COMPLY WITH O.R.S. 209.250

FOR: Medford Water Commission
City Hall
Medford, Oregon

LOCATION: DLC #68, Section 22, Township 37 South,
Range 2 West, Willamette Meridian.

PURPOSE: To re-monument the West boundary, and
prepare a revised description of that
parcel proposed to be conveyed to the
City by Hanly and Heffernan for
reservoir purposes.

PROCEDURE:

Found pins previously set on Recorded Survey No. 2114,
and re-set same for a line 80.00 feet East from the
original monumented West boundary.

March 1963

