
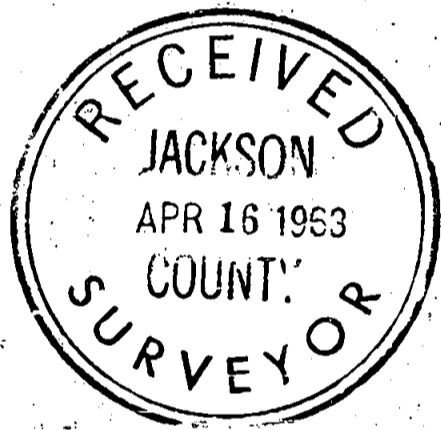
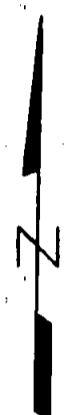


2154

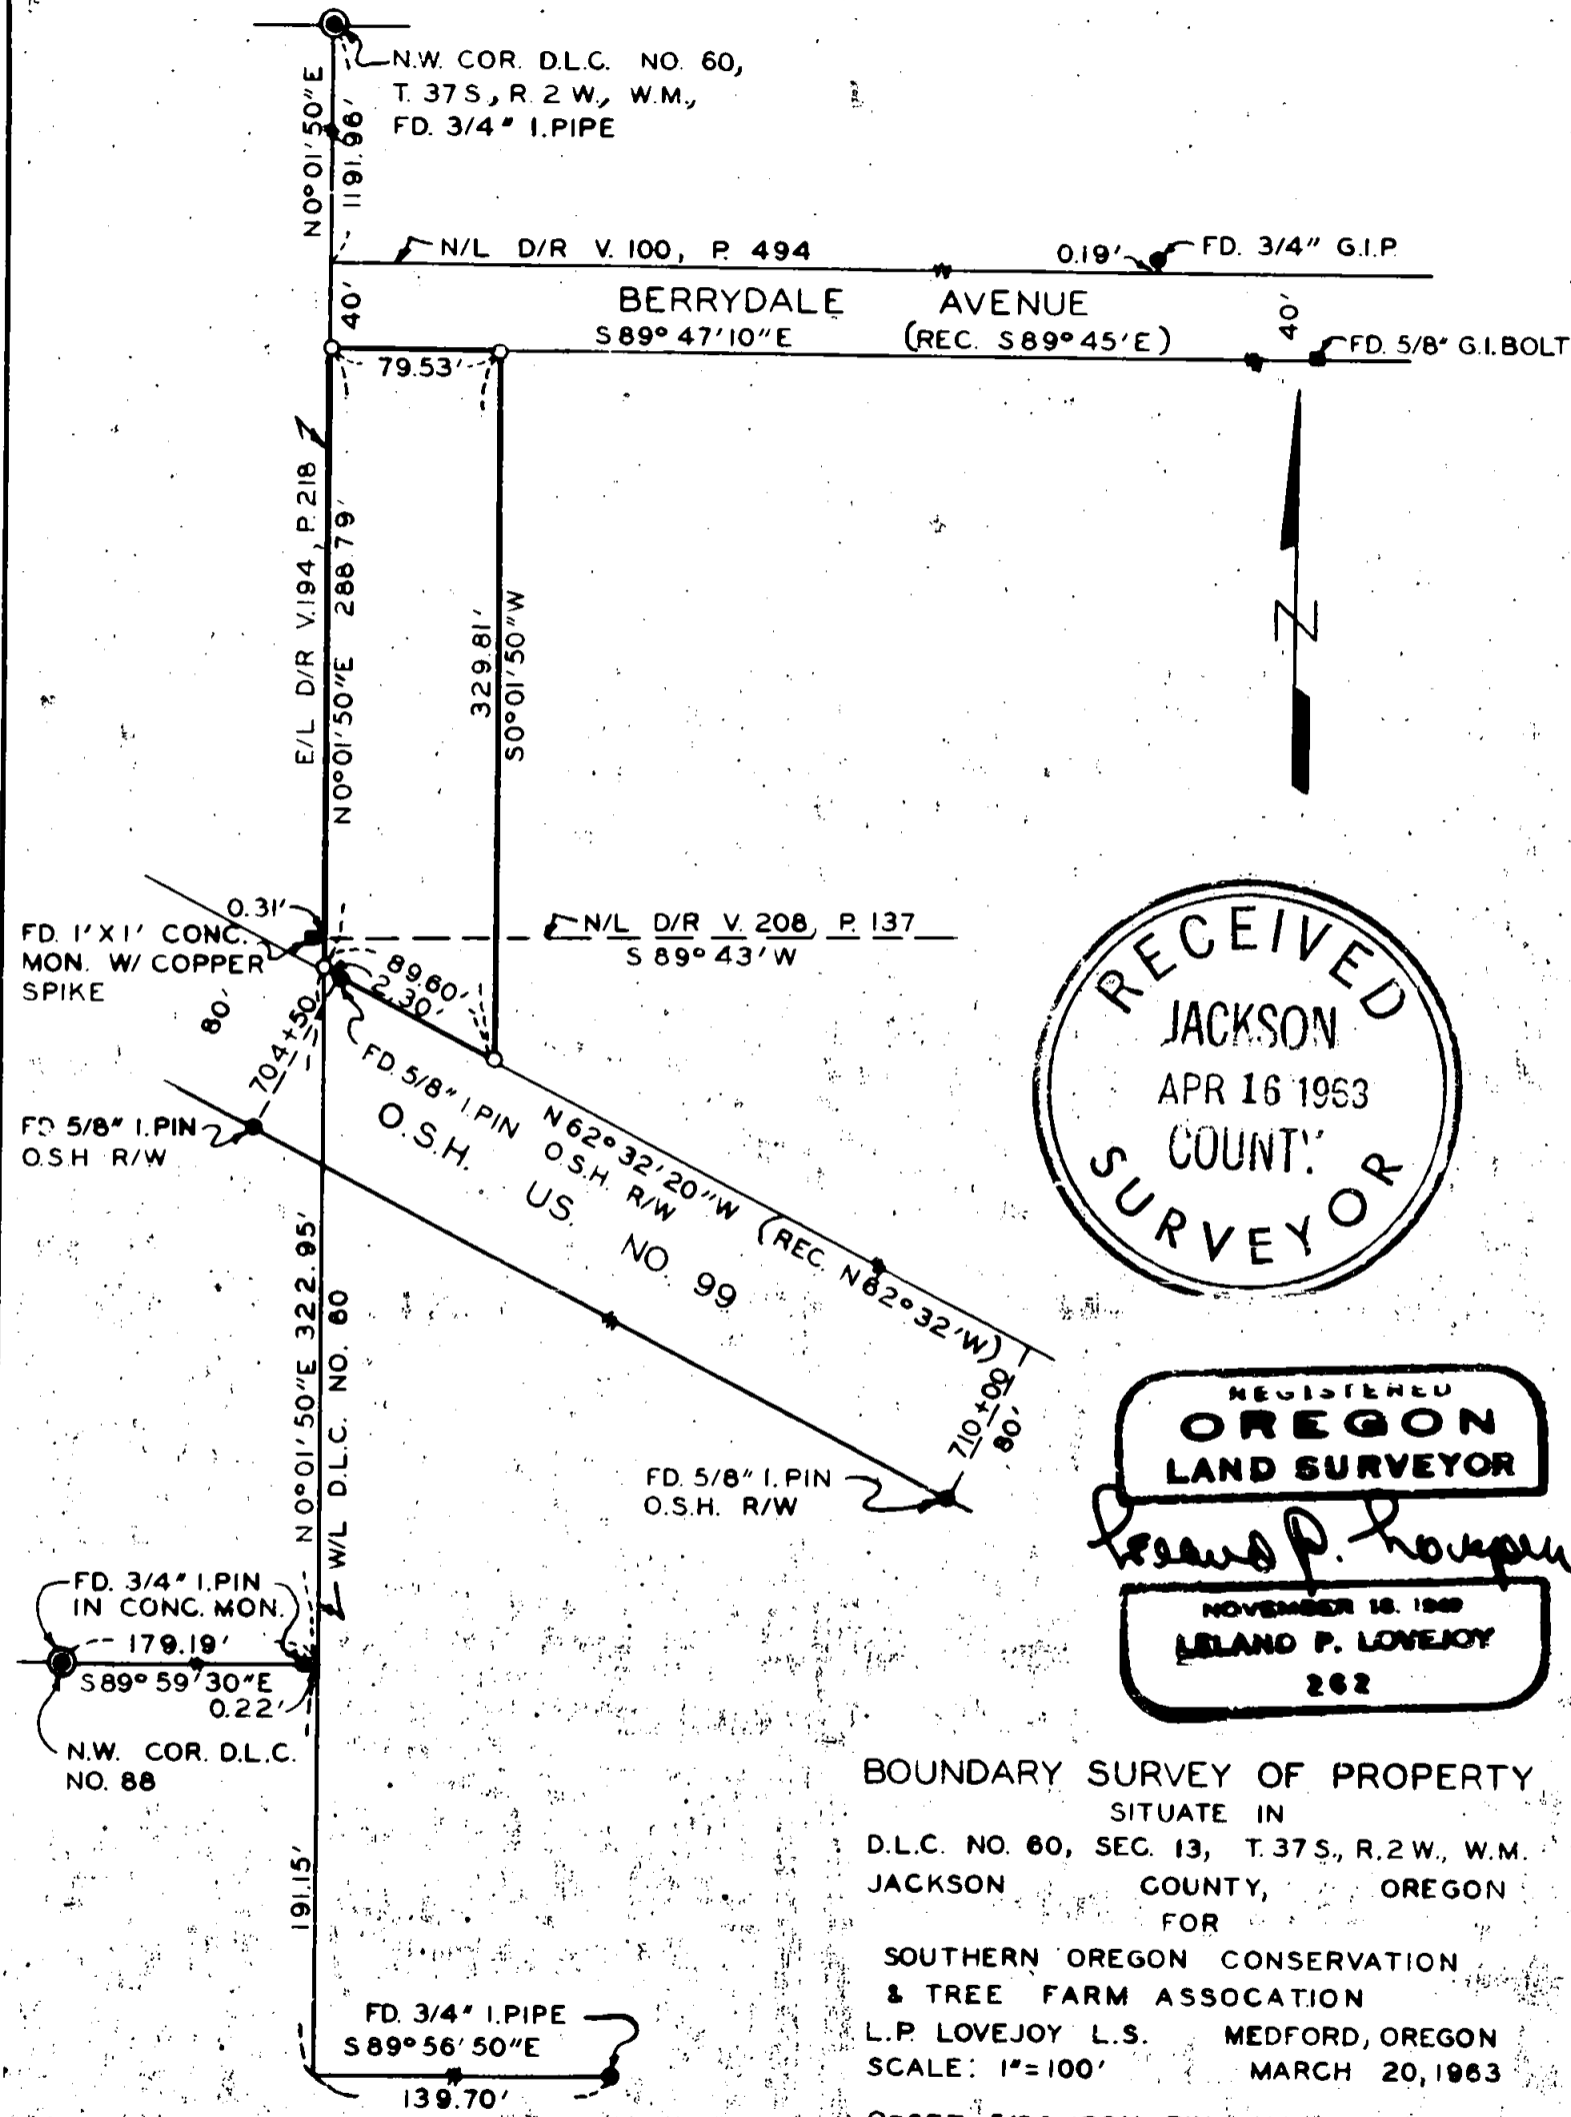

REGISTERED
OREGON
LAND SURVEYOR


262

BOUNDARY SURVEY OF PROPERTY
SITUATE IN
D.L.C. NO. 60, SEC. 13, T. 37S., R. 2W., W.M.
JACKSON COUNTY, OREGON
FOR

SOUTHERN OREGON CONSERVATION
& TREE FARM ASSOCIATION
L.P. LOVEJOY L.S. MEDFORD, OREGON
SCALE: 1"=100' MARCH 20, 1963

O=SET 5/8" IRON PIN
BEARINGS BY PREVIOUS SURVEY

2154

SURVEY NARRATIVE TO COMPLY WITH SECTION 87-3301947 OREGON STATE LAWS

Survey For: Southern Oregon Conservation
and Tree Farm Association
518 East Main Street
Medford, Oregon

Purpose of Survey: To establish property boundaries
and corners.

Survey Location: D. L. C. No. 60, Section ^{13th} ~~18~~,
Township 37 South, Range 2 West,
Willamette Meridian, Jackson
County, Oregon.

Survey Procedure: Found D. L. C. corners and other
survey points and monuments as
shown on map and used as a basis
for survey control. Set 5/8" iron
pins as shown on map.

Leland P. Lovejoy
Registered Land Surveyor

Work Completed March 20, 1963

REGISTERED
OREGON
LAND SURVEYOR

NOVEMBER 18, 1949
LELAND P. LOVEJOY
262

