


MAP OF SURVEY
FOR
GARY BALFOUR

LOCATED IN:
THE S.E. 1/4 OF SEC. 29, T.37S., R. 2W., W.M.,
CITY OF JACKSONVILLE, JACKSON COUNTY, OREGON

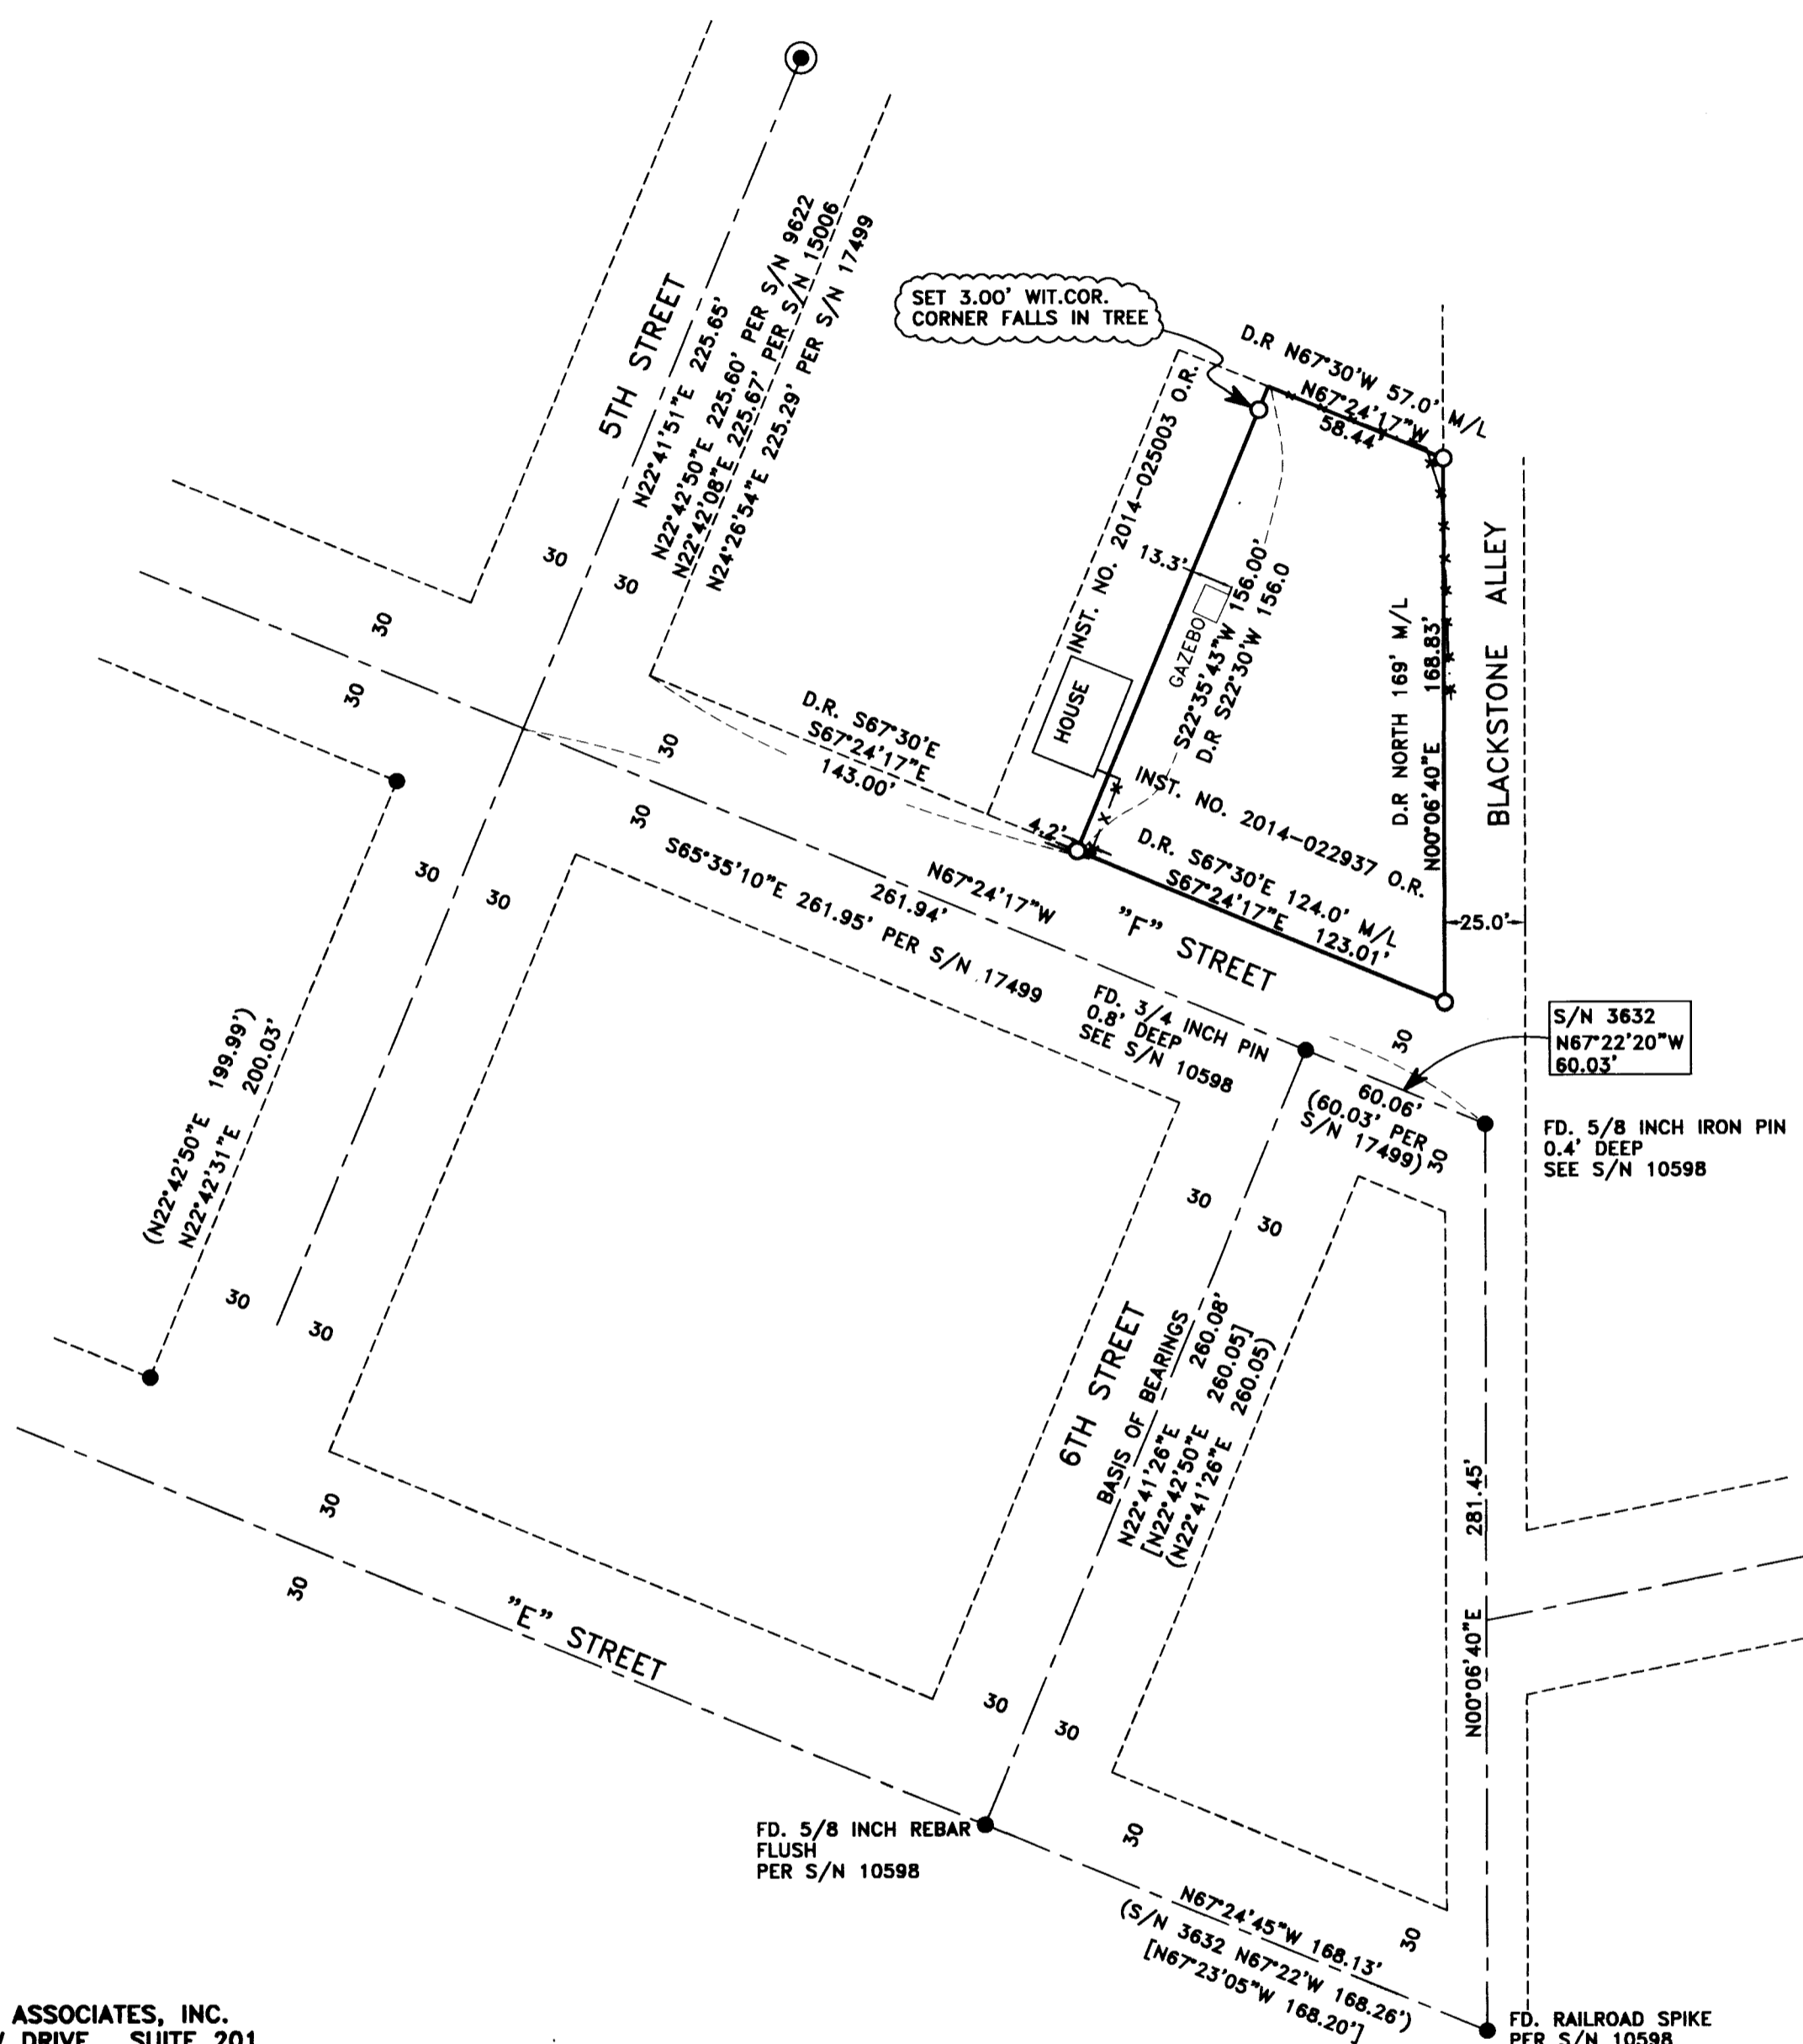

HOFFBUHR & ASSOCIATES, INC.
880 GOLF VIEW DRIVE, SUITE 201
MEDFORD, OREGON 97504
(541)779-4641

BY: DARRELL L. HUCK PLS No. 2023
SCALE: 1 inch = 50' November 21, 2014
BASIS OF BEARING: SURVEY NO. 19048

- = Set 5/8"x24" iron reinforcing pin with plastic cap stamped "D. Huck LS 2023".
- = Found lead plug w/ tag marked "2653" per S/N 19048 unless noted otherwise
- ⊙ = Found 1/2 inch pipe in mon. case per S/N 9622
- S/N = Survey Number
- D.R. = Deed Record per Inst. No. 2014-022937
- O.R. = Official Records, Jackson County, Oregon
- (-) = Record per Survey No. 19048
- [-] = Record per Survey No. 10598
- *-x-* = Fence line

SURVEY NARRATIVE TO COMPLY WITH PARAGRAPH 209.250
OREGON REVISED STATUTES

PURPOSE: To survey and monument the boundary of that property described in Instrument No. 2014-022937 of the Official Records of Jackson County, Oregon

PROCEDURE: A control traverse was run tying monuments found per filed Surveys No. 9622, 12662, 10598 and 19048. Monuments per surveys no. 9622 and 19048 were held to control the location of 5th Street. Monuments found per surveys no. 10598 and 19048 were held to control the location of "F" Street and the location of Blackstone Alley was determined per survey no. 12662. The property boundary was computed according to deed record dimensions and monuments were set as shown.

Equipment used: Trimble S6 Robotic instrument.

RECEIVED
Date 1/2/15 By [Signature]
This survey consists of:
1 sheet(s) Map
1 page(s) Narrative
JACKSON COUNTY
SURVEYOR

REGISTERED
PROFESSIONAL
LAND SURVEYOR
Darrell L. Huck
OREGON
FEBRUARY 4, 1985
DARRELL L. HUCK
2023
Expires 6/30/2015
(14086 MOS.DWG)