


N0°01'30"W 1986.27' (REC. N0°03'E 1984.8')
 W/L SPRINGBROOK SUBDIVISION
 1626.42' PD. (REC. 1625.2') 801.10' PD. (REC. 800.5') 329.85' PD. (REC. 32.6')

SPRINGBROOK SUBDIVISION

SPRINGBROOK

BOUNDARY SURVEY OF PROPERTY
 SITUATE IN
 LOTS 7, 10 & 12 OF SPRINGBROOK SUBDIVISION
 IN THE E 1/2, NW 1/4, SEC. 17, T. 37 S., R. 14 W., WM.
 COUNTY, OREGON
 FOR
 HENRY F. PADGHAM
 L.P. LOVELOY L.S. MEDFORD, OREGON
 SCALE: 1" = 100'
 BEARINGS BY PREVIOUS SURVEY
 O=SET 5/8" IRON PIN

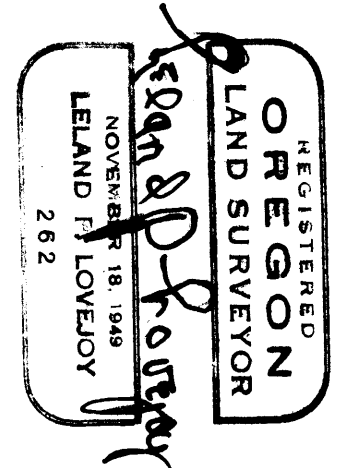

ROBERTS, ROAD
 S.E. COR. SPRINGBROOK SUBD.
 BRASS CAP WITH X BEARS
 N 89° 55' 10" W 0.69' FROM STONE

N-S E SECTION 17
 E/L SPRINGBROOK SUBD.

SURVEY NARRATIVE TO COMPLY WITH SECTION 87-3301947 OREGON STATE LAWS

Survey For: Henry F. Padgham
1309 Court Street
Medford, Oregon

Purpose of Survey: To establish property boundaries
and corners.

Survey Location: Lots 7, 10 and 12, Springbrook
Subdivision (Recorded), Section 17,
Township 37 South, Range 1 West,
Willamette Meridian, Jackson
County, Oregon.

Survey Procedure: Found survey monuments and
corners as shown on map and used
as a basis for survey control.
Proportioned excess and deficiency
of measurements over and under
record measurements as shown on
map. Set 5/8" iron pins as shown
on map.

Leland P. Lovejoy
Registered Land Surveyor

Work Completed March 11, 1963

