

**SURVEY NARRATIVE TO COMPLY WITH PARAGRAPH 209.250 OREGON REVISED STATUTES**

**FOR: ELK LUMBER COMPANY**

**PURPOSE:** To rehabilitate and perpetuate the Section corner common to Sections 12 and 13, Township 32 South, Range 3 East and Sections 7 and 18, Township 32 South, Range 4 East, W.M.

**PROCEDURE:**


Found the original corner monument which is a basalt stone 10 inches by 12 inches by 16 inches, set firmly in place and showing 4 notches on the South face and 2 notches on the North face. Also found the original Southwest BT which is now a 54 inch Douglas fir in good condition. I cut through approximately 7 inches of overgrowth and exposed scribing in the upper face of this Southwest BT. All the other original BT's were destroyed by fire many years ago. We found stump holes corresponding to the record locations of the Northeast and Southeast BT's but no trace of the original Northwest BT.

The relative positions of the corner stone and face of blaze of the Southwest BT agreeing very closely to the official record, I used the center of the stone as the corner point and, after referencing that point, removed the original stone and set in its place a 1 inch by 36 inch galvanized steel pipe driven 30 inches in the ground and capped with a 1-1/2 inch to 1 inch galvanized bell reducer filled with pot metal and stamped as shown below in 1/8 inch letters and numerals:

1963  
 T 32S  
 R 3E R 4E  

|    |    |
|----|----|
| 12 | 7  |
| 13 | 18 |

 SEC COR  
 RS 583

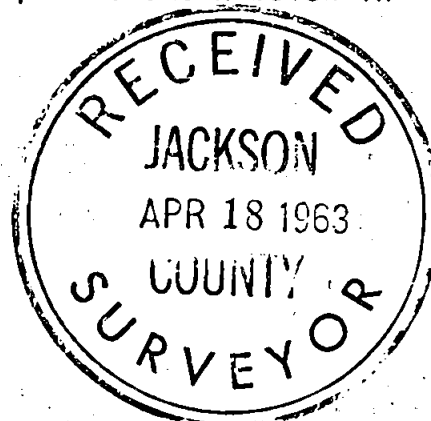


The original cornerstone was placed on the north side of the above-described monument.

From the center of the corner pipe an 8 inch White Fir, double blazed and scribed "RS 583" in the upper blaze and "BT" in the lower bears North 40°00' East 16.6 feet; a 7 inch White Fir double blazed and scribed "RS 583" in the upper blaze and "BT" in the lower bears South 21°00' East 18.1 feet; and a 10 inch White Fir double blazed and scribed "RS 583" in the upper blaze and "BT" in the lower bears North 23°00' West 28.8 feet.

Compass variation was set at 20°00' East, distances were taken to face of blaze.

Field work by Robert M. Vincent and Brice L. Brandt.

April 9, 1963

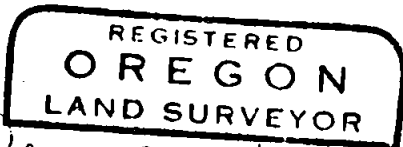

*Robert M. Vincent*

