21681

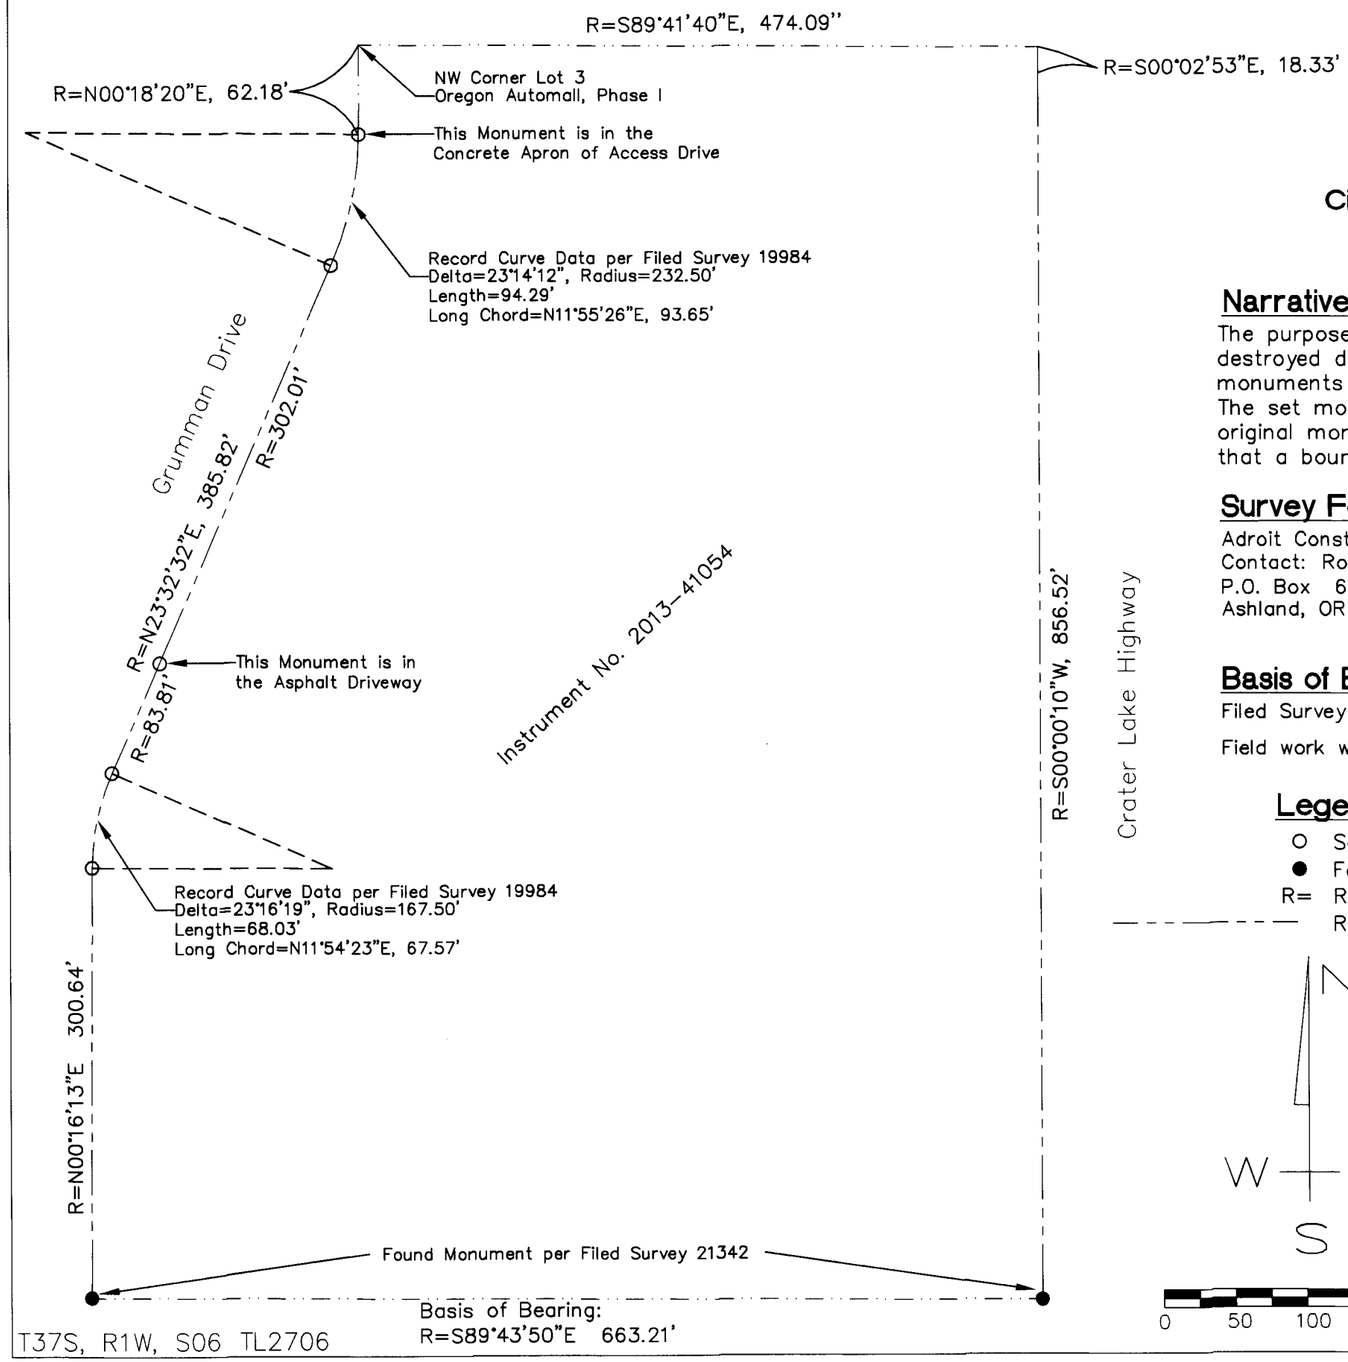

Map of Survey

Located In:
SE 1/4 of Sec. 6, T37S, R1W, W.M.
City of Medford, Jackson County, OR

FILED
Date 3/25/15 By PB
This Survey Consists Of:
1 sheet(s) Map
0 page(s) Narrative
JACKSON COUNTY SURVEYOR

Narrative:

The purpose of this survey is to reset those monuments destroyed during a recent construction project. The destroyed monuments were tied in and referenced prior to construction. The set monuments were replaced in the same location as the original monuments. This survey does not represent or imply that a boundary survey has been performed.

Survey For:

Adroit Construction Co. Inc.
Contact: Robb Mayers
P.O. Box 609
Ashland, OR 97520

Survey By:

Pariani Land Surveying
John R. Pariani, PLS
P.O. Box 551
Shady Cove, OR 97539

Basis of Bearings:

Filed Survey 21342

Field work was completed March, 2015.

Legend

- O Set 5/8"x30" Rebar with Cap "PARIANI PLS 51382"
- ● Found 5/8" Rebar with Cap "Hardey Eng. & Assoc."
- R= Record Data per Filed Survey 21342
- — — — — Record Property Line per Filed Survey 21342

REGISTERED PROFESSIONAL LAND SURVEYOR
OREGON
July 13, 1999
JOHN R. PARIANI
#51382
Renews: December 31, 2016

N
W E
S
0 50 100 200

Map of Survey – Reset Monuments

Pariani Land Surveying

P.O. Box 551
Shady Cove, OR 97539
541-890-1131

Date:	Scale:	Job No.:	Sheet:
March 24, 2015	1" = 100'	2014-164	1 of 1

21681