


2171

Survey For :
WESTERN FRUIT COMPANY INC.
Located in Sec. 8, T.37S., R.1W., W.M.
By : Mark E. Boyden
April, 1963

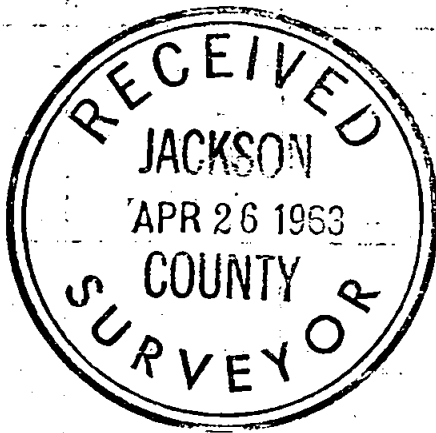

2171

Section cor. 5/4 8/9

Fd. iron pin S 87°06'40"E 297.60' Fd. iron pin 237.51'

352.96'

1.90 ACRES

341.42'

SCALE: 1" = 100'
• Set 5/8" iron pin

C See Recorded Survey No. 601 J

N 0°07'40"E

337.40'

1.07 AC.

S 89°54'E 239.52' 138.00' 101.52'

N 0°07'40"E

337.40'

0.80 AC.

S 0°15'20"E

678.83'

0.93 ACRES

675.90'

S 0°15'20"E

Fd. iron pin 138.00' 103.77' 60.00' Fd. 1" iron pipe 301.77'

DELTA WATERS ROAD

1/4 Section cor. 8/17

N 89°54' W

Section cor. 8/17 16/9

2171

REGISTERED OREGON LAND SURVEYOR

MARK E. BOYDEN
NOVEMBER 9, 1951
MARK E. BOYDEN
281

Survey No. 2171

SURVEY NARRATIVE TO COMPLY WITH O.R.S. 209.250

FOR: Western Fruit Co., Inc.
c/o Herried Real Estate
11 King Street
Medford, Oregon

LOCATION: Southeast 1/4 of the Southeast 1/4 of Section 8,
Township 37 South, Range 1 West.

PURPOSE: To monument and describe in three parcels, with
a proposed 60.00 foot roadway, that tract
described in Volume 487, Page 232 of the Deed
Records of Jackson County, Oregon.

PROCEDURE:

Found the outside boundary corner monuments as
previously set on Recorded Survey No. 601.

Set additional 5/8" iron pins as shown.

April 1963

