




BASIS OF BEARING IS TRUE NORTH, NAD 83/91 DATUM, AS DERIVED BY GLOBAL POSITIONING SYSTEM OBSERVATIONS.

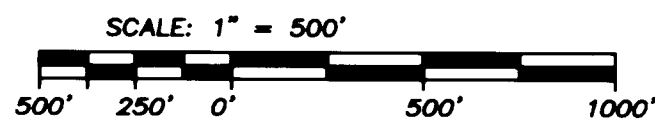

NOTE: ALL SOLID LINES SHOWN HEREON HAVE BEEN MARKED AND BLAZED TO HANCOCK FOREST MANAGEMENT STANDARDS.

T.31S R.3E  
T.32S R.3E

34 35  
3 2

FOUND 3" BLM BRASS CAP STAMPED "1962" GROUP No 350.

S0°06'52"E 2670.14  
(S0°00'45"E 2608.64 G.L.O. PLAT)  
(S0°00'45"E 39.54 CHAINS G.L.O. PLAT)

2  
3 1/4

FOUND 2 1/2" EXPANDER FILLED WITH POT METAL EXPOSED 1.00 FEET, STAMPED "R.S. 583, 1963" ALSO STAMPED "LS 1071 1979" S/N 2166 AND S/N 8242.

S0°00'42"W 2673.52  
(S0°00'45"E 2640.00 G.L.O. PLAT)  
(S0°00'45"E 40 CHAINS G.L.O. PLAT)

3 2  
10 11

(S89°30'00"W 79.50 CHAINS G.L.O. PLAT)  
(S89°30'00"W 5247.00 G.L.O. PLAT)  
S89°55'20"W 5131.16

(S89°28'00"W 39.74 CHAINS G.L.O. PLAT)  
(S89°28'00"W 2622.84 G.L.O. PLAT)  
N89°43'26"W 2665.87

1/4 2  
11

FOUND 1 1/2" EXPANDER FILLED WITH POT METAL STAMPED "CS 1954" PER J.C.R.N. DATED OCTOBER 1954. CAP WAS ALSO STAMPED BY THE BLM IN 1962, BLM GROUP No 350.

FOUND 2 1/2" BRASS CAP MARKED "SWAIN SURVEYING, PLS 759" PER S/N 5798

FOUND 2 1/2" BRASS CAP PER J.C.R.N. SEPTEMBER 10, 1984

S/N 21655

MAP OF SURVEY

located in

SECTION 2, SECTION 3, SECTION 10, AND SECTION 11, TOWNSHIP 32 SOUTH, RANGE 3 EAST, WILLAMETTE MERIDIAN, JACKSON COUNTY, OREGON

for

HANCOCK FOREST MANAGEMENT

572 PARSONS DRIVE, SUITE 124  
MEDFORD, OREGON 97501

LEGEND

- = FOUND SECTION CORNER, AS DESCRIBED
- = FOUND QUARTER CORNER, AS DESCRIBED
- S/N = RECORD FILED SURVEY NUMBER
- G.L.O. = GENERAL LAND OFFICE
- J.C.R.N. = JACKSON COUNTY RE-ESTABLISHMENT NOTES

\*\*\* FILED \*\*\*  
DATE 9/18/15 BY PB  
This survey consists of:  
1 sheet(s) Map  
2 page(s) Narrative  
JACKSON COUNTY  
SURVEYOR

REGISTERED  
PROFESSIONAL  
LAND SURVEYOR

*Herbert A. Farber*  
OREGON  
JULY 26, 1985  
HERBERT A. FARBER  
2180

RENEWAL DATE 12-31-15

SURVEY NARRATIVE  
TO COMPLY WITH O.R.S. 209.250

Purpose: This survey was conducted to mark the lines shown hereon per Hancock Forest Management Inc. standards. The project name for this site is Slinky.

Procedure: This survey was conducted using Trimble GPS 5800 and R-8 receivers and Trimble 5600 robotic total station. The survey was ran as a closed survey shown hereon. After we tied the found monuments we marked the line between said monuments. No Monuments were set on this survey.

Surveyed by:  
FARBER & SONS, INC. dba



PO BOX 5286  
431 OAK STREET  
CENTRAL POINT, OREGON 97502  
(541) 664-5599

DATE: AUGUST 18, 2015  
JOB NO.: 2237-14

DRAWING FILE: JOBS\Hancock Forest\Slinky\MOS 081415.DWG

DRAWN BY: LSH ORIG. DATE: 08/18/2015 REVISED BY: DATE: