

REGISTERED  
**OREGON**  
 LAND SURVEYOR  
*W. Leland P. Lovejoy*  
 NOVEMBER 19, 1948  
**WILLIAM F. LOVEJOY**  
 202

BOUNDARY SURVEY OF PROPERTY  
 SITUATE IN  
 N.E. 1/4, SEC. 3, T. 37 S., R. 2 W., W.M.  
 JACKSON COUNTY OREGON  
 FOR  
 WILLIE GERMANN  
 L.P. LOVEJOY L.S. MEDFORD, OREGON  
 SCALE: 1" = 100' APRIL 16, 1963  
 BEARINGS BY PREVIOUS SURVEY  
 ○ = SET 5/8" IRON PIN  
 ● = FD. BRASS CAP W/PUNCH IN CONC.  
 MON.

RECEIVED  
 JACKSON  
 MAY 13 1963  
 COUNTY  
 SURVEYOR

SURVEY NARRATIVE TO COMPLY WITH SECTION 87-3301947 OREGON STATE LAWS

Survey For: Willie and Lula Germann  
1694 Scenic Avenue  
Central Point, Oregon



Purpose of Survey: To survey property boundaries of  
real property to be sold.

Survey Location: Northeast Quarter (1/4) of Section 3,  
Township 37 South, Range 2 West,  
Willamette Meridian, Jackson County,  
Oregon.

Survey Procedure: Found survey monuments and legal  
corners, as shown on map, and used as  
basis for survey control. Set 5/8" iron  
pins as shown.

Leland P. Lovejoy  
Registered Land Surveyor

Work completed April 16, 1963

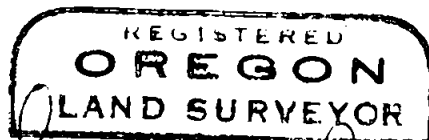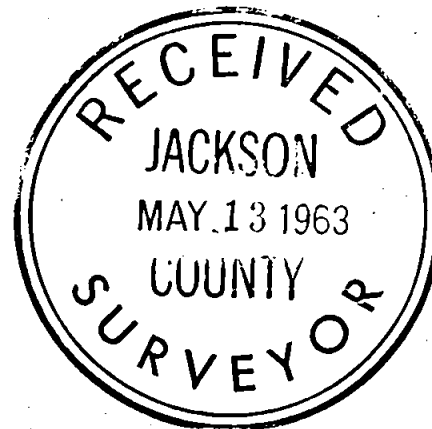

*Leland P. Lovejoy*

