


LAKE AGATE ESTATES


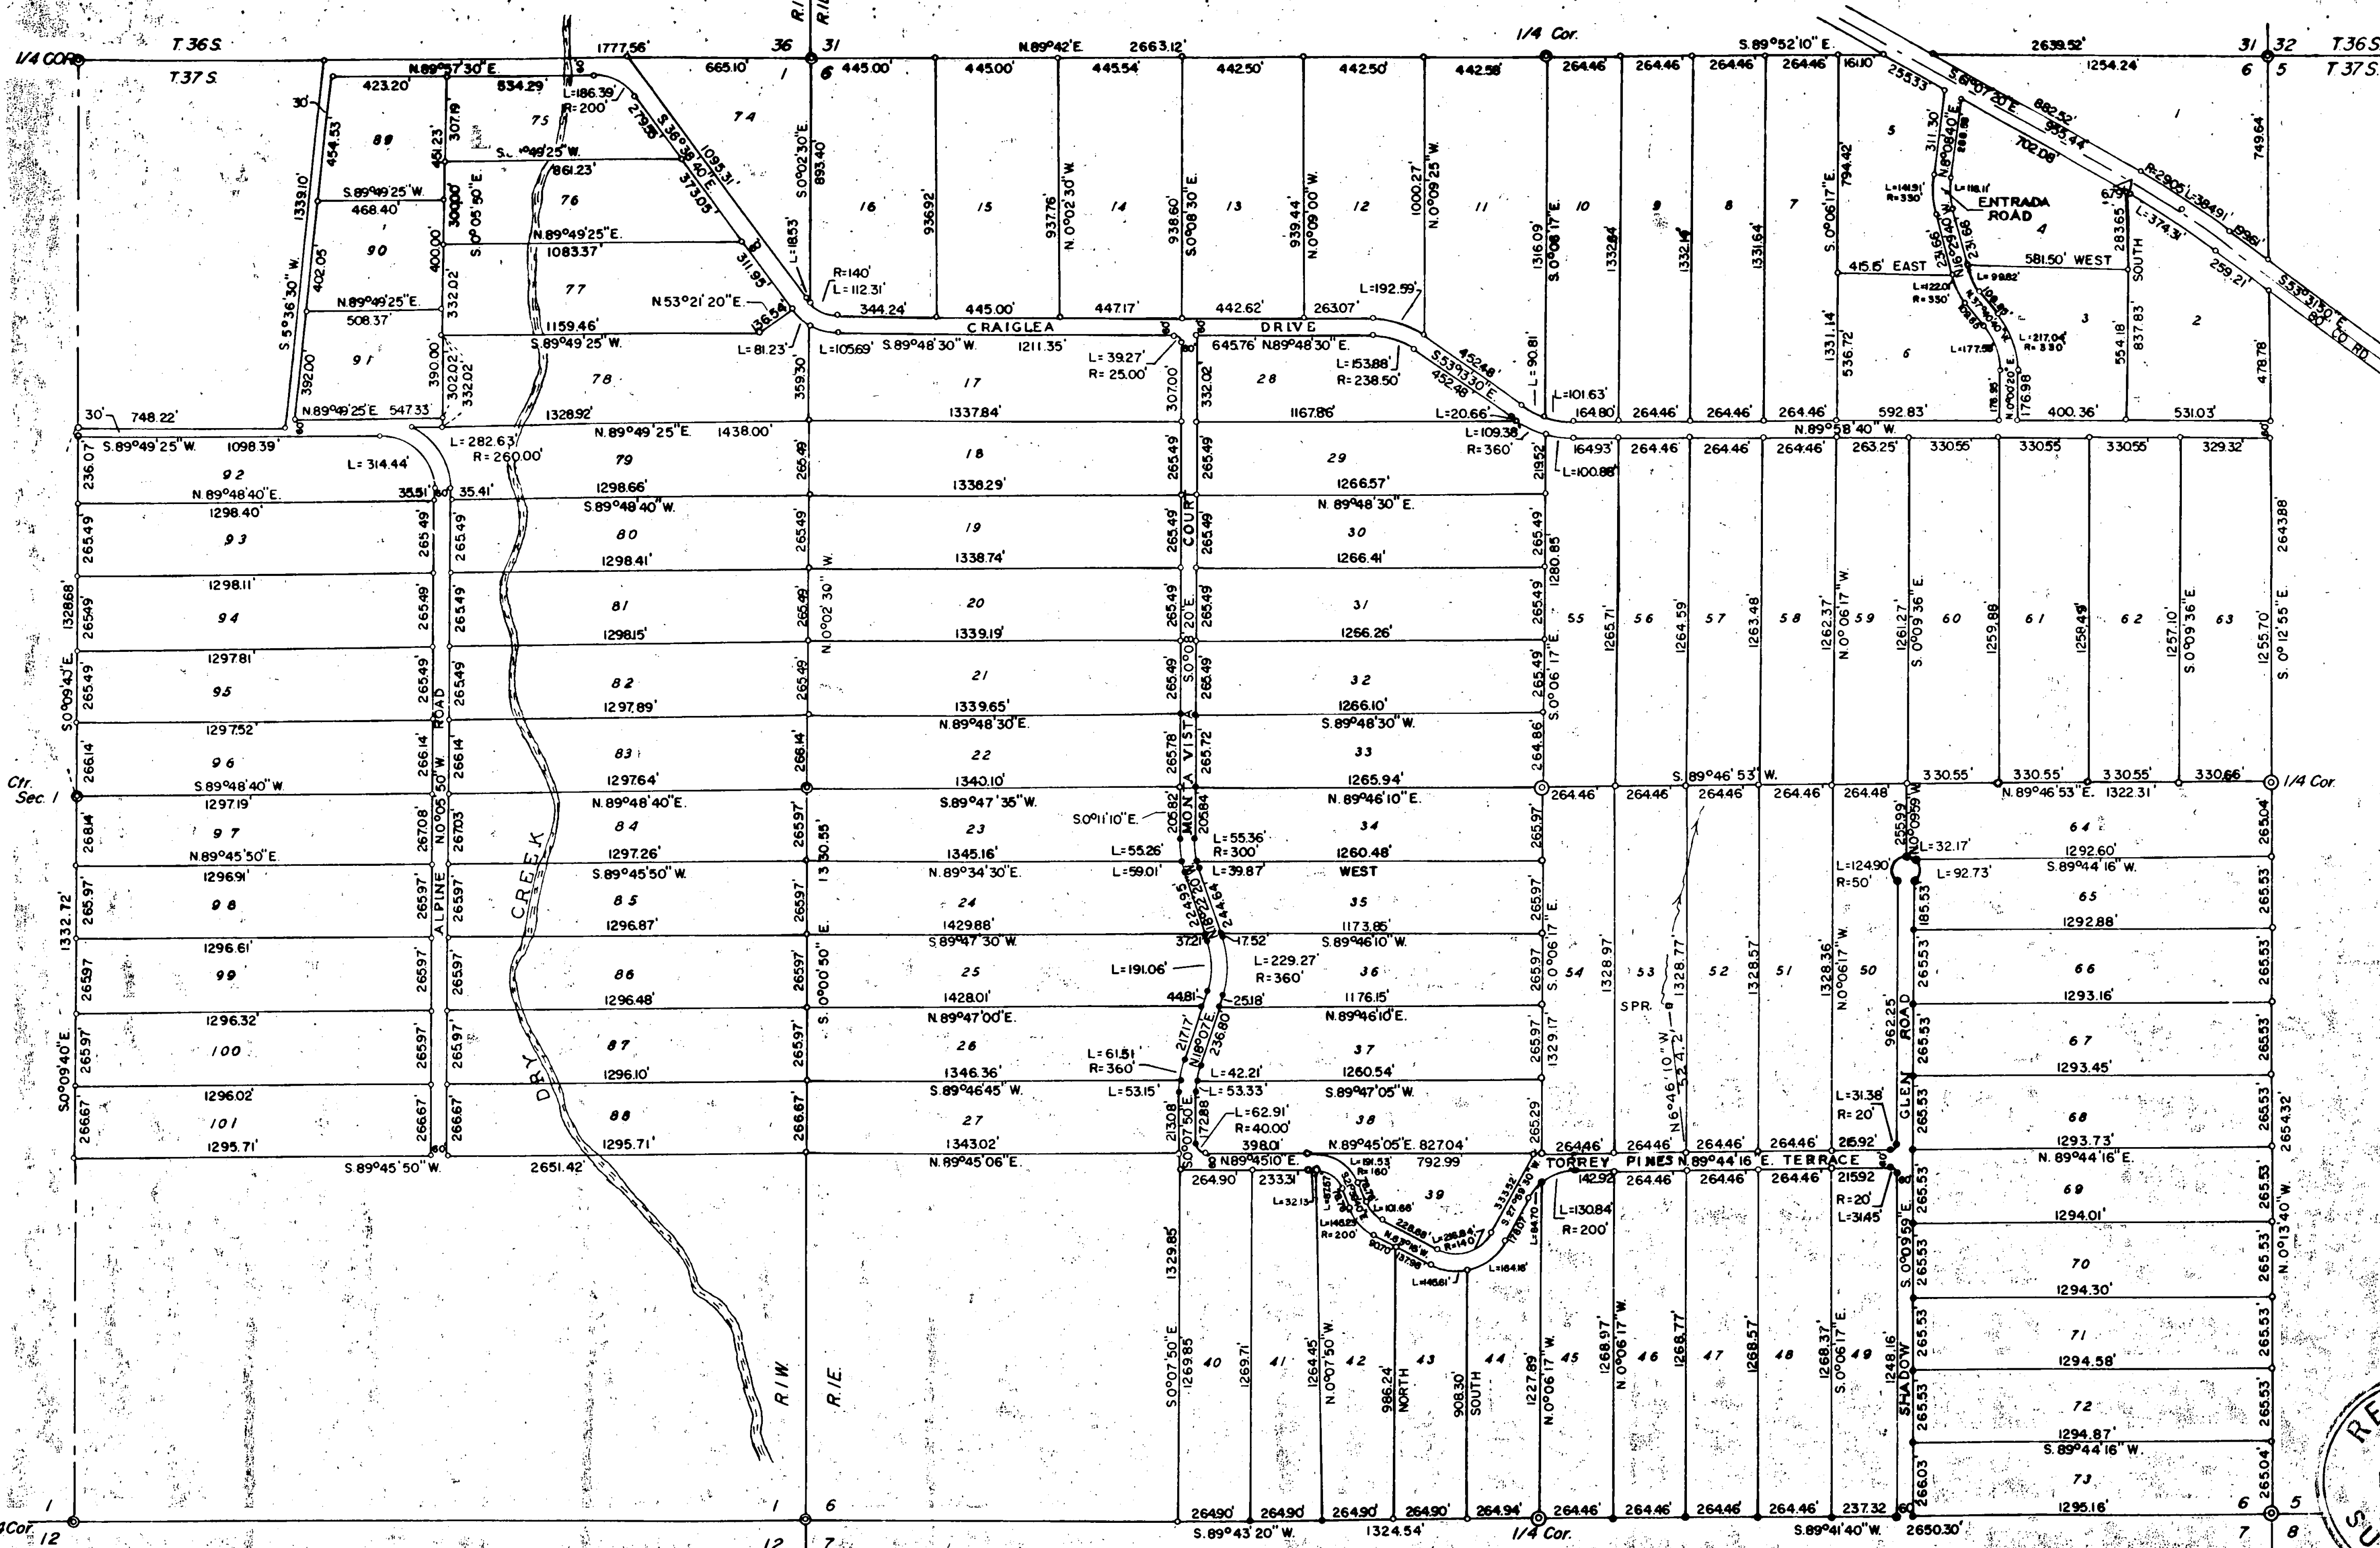


SURVEY IN SEC. 1, T. 37 S., R. 1 W., & IN SEC. 6, T. 37 S., R. 1 E., W.M.

FOR
FAYDREX INC.
(62-27-1,2)

BY EDWARD MCGINTY
MEDFORD, OREGON
APRIL 1963

SCALE 1" = 400'
• = 5/8" Iron Pin
• = 1/2" Iron Pin
● = COR. FD - SEE - NAR.

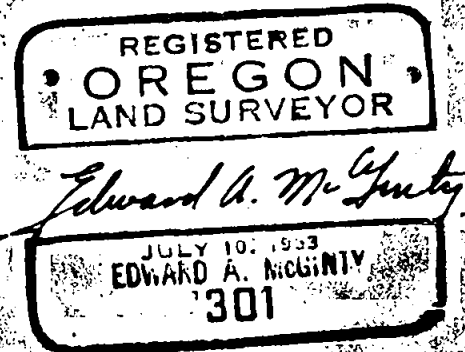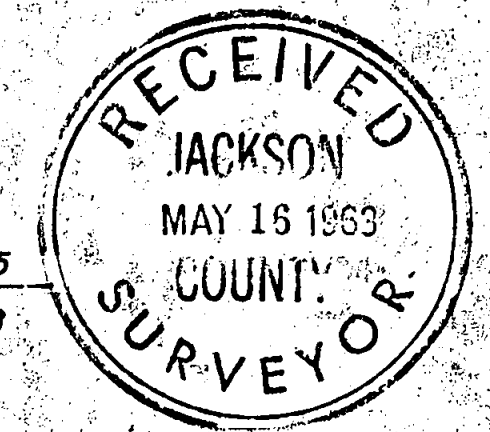

Survey No. 2188

Survey Narrative to comply with O.R.S. 209-250.


Survey for: Faydrex Inc.
843 E. Main St.

Survey by: Edward A. McGinty, L.S.
5/3/63

BASIS OF BEARING: Solar observation from previous survey.

PRECEDENCE OF SURVEY:

Sub-divided portions of Section 6 and Section 1, as requested by client, into tracts of land as shown, also layed out roads with the approval of the County Planning Commission.

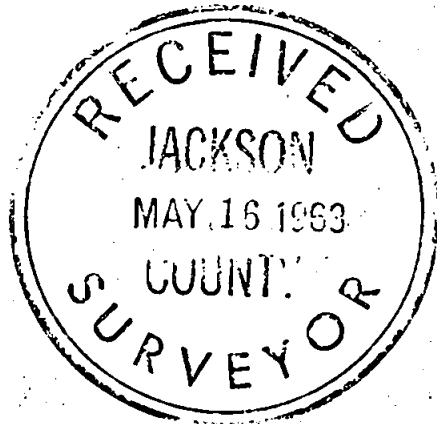

Edward A. McGinty

