

# MAP OF SURVEY FOR SUSAN LOPEZ


LOCATED IN:  
 IN THE S.E. 1/4 SEC. 16, T.36S., R3W., W.M.  
 CITY OF GOLD HILL, JACKSON COUNTY, OREGON

SURVEY NARRATIVE TO COMPLY WITH PARAGRAPH 209.250  
 OREGON REVISED STATUTES

PURPOSE: To survey and monument Lot 6, Block 5 in Dekum's Amended Addition to the City of Gold Hill as conveyed in Instrument No. 03-17610 of the Official Records of Jackson County, Oregon

PROCEDURE: Lot 6 has been previously surveyed and monumented by surveyor George Plumb in 1972 per survey No. 4903. The south line of the Lot 6 was resurveyed and monumented by Darrel Edwards in 1986 per file survey No. 10545. Both surveys utilized centerline monuments located in Sixth Avenue, from Survey No. 3458 for their basis of control. Following the precedent set by previous surveys, I held centerline monuments as found in Sixth Avenue as basis of control for this survey. I computed the location of Lot 6 from plat record angle and distance, which is in close harmony with surveys by Edwards and Plumb. There is an existing paved driveway across the southern portion of Lot 6, as shown, which is used by the residence in Lot 5 and there is a deck encroachment along the east line of Lot 6 as shown.

Equipment used: Trimble S6 Robotic instrument.

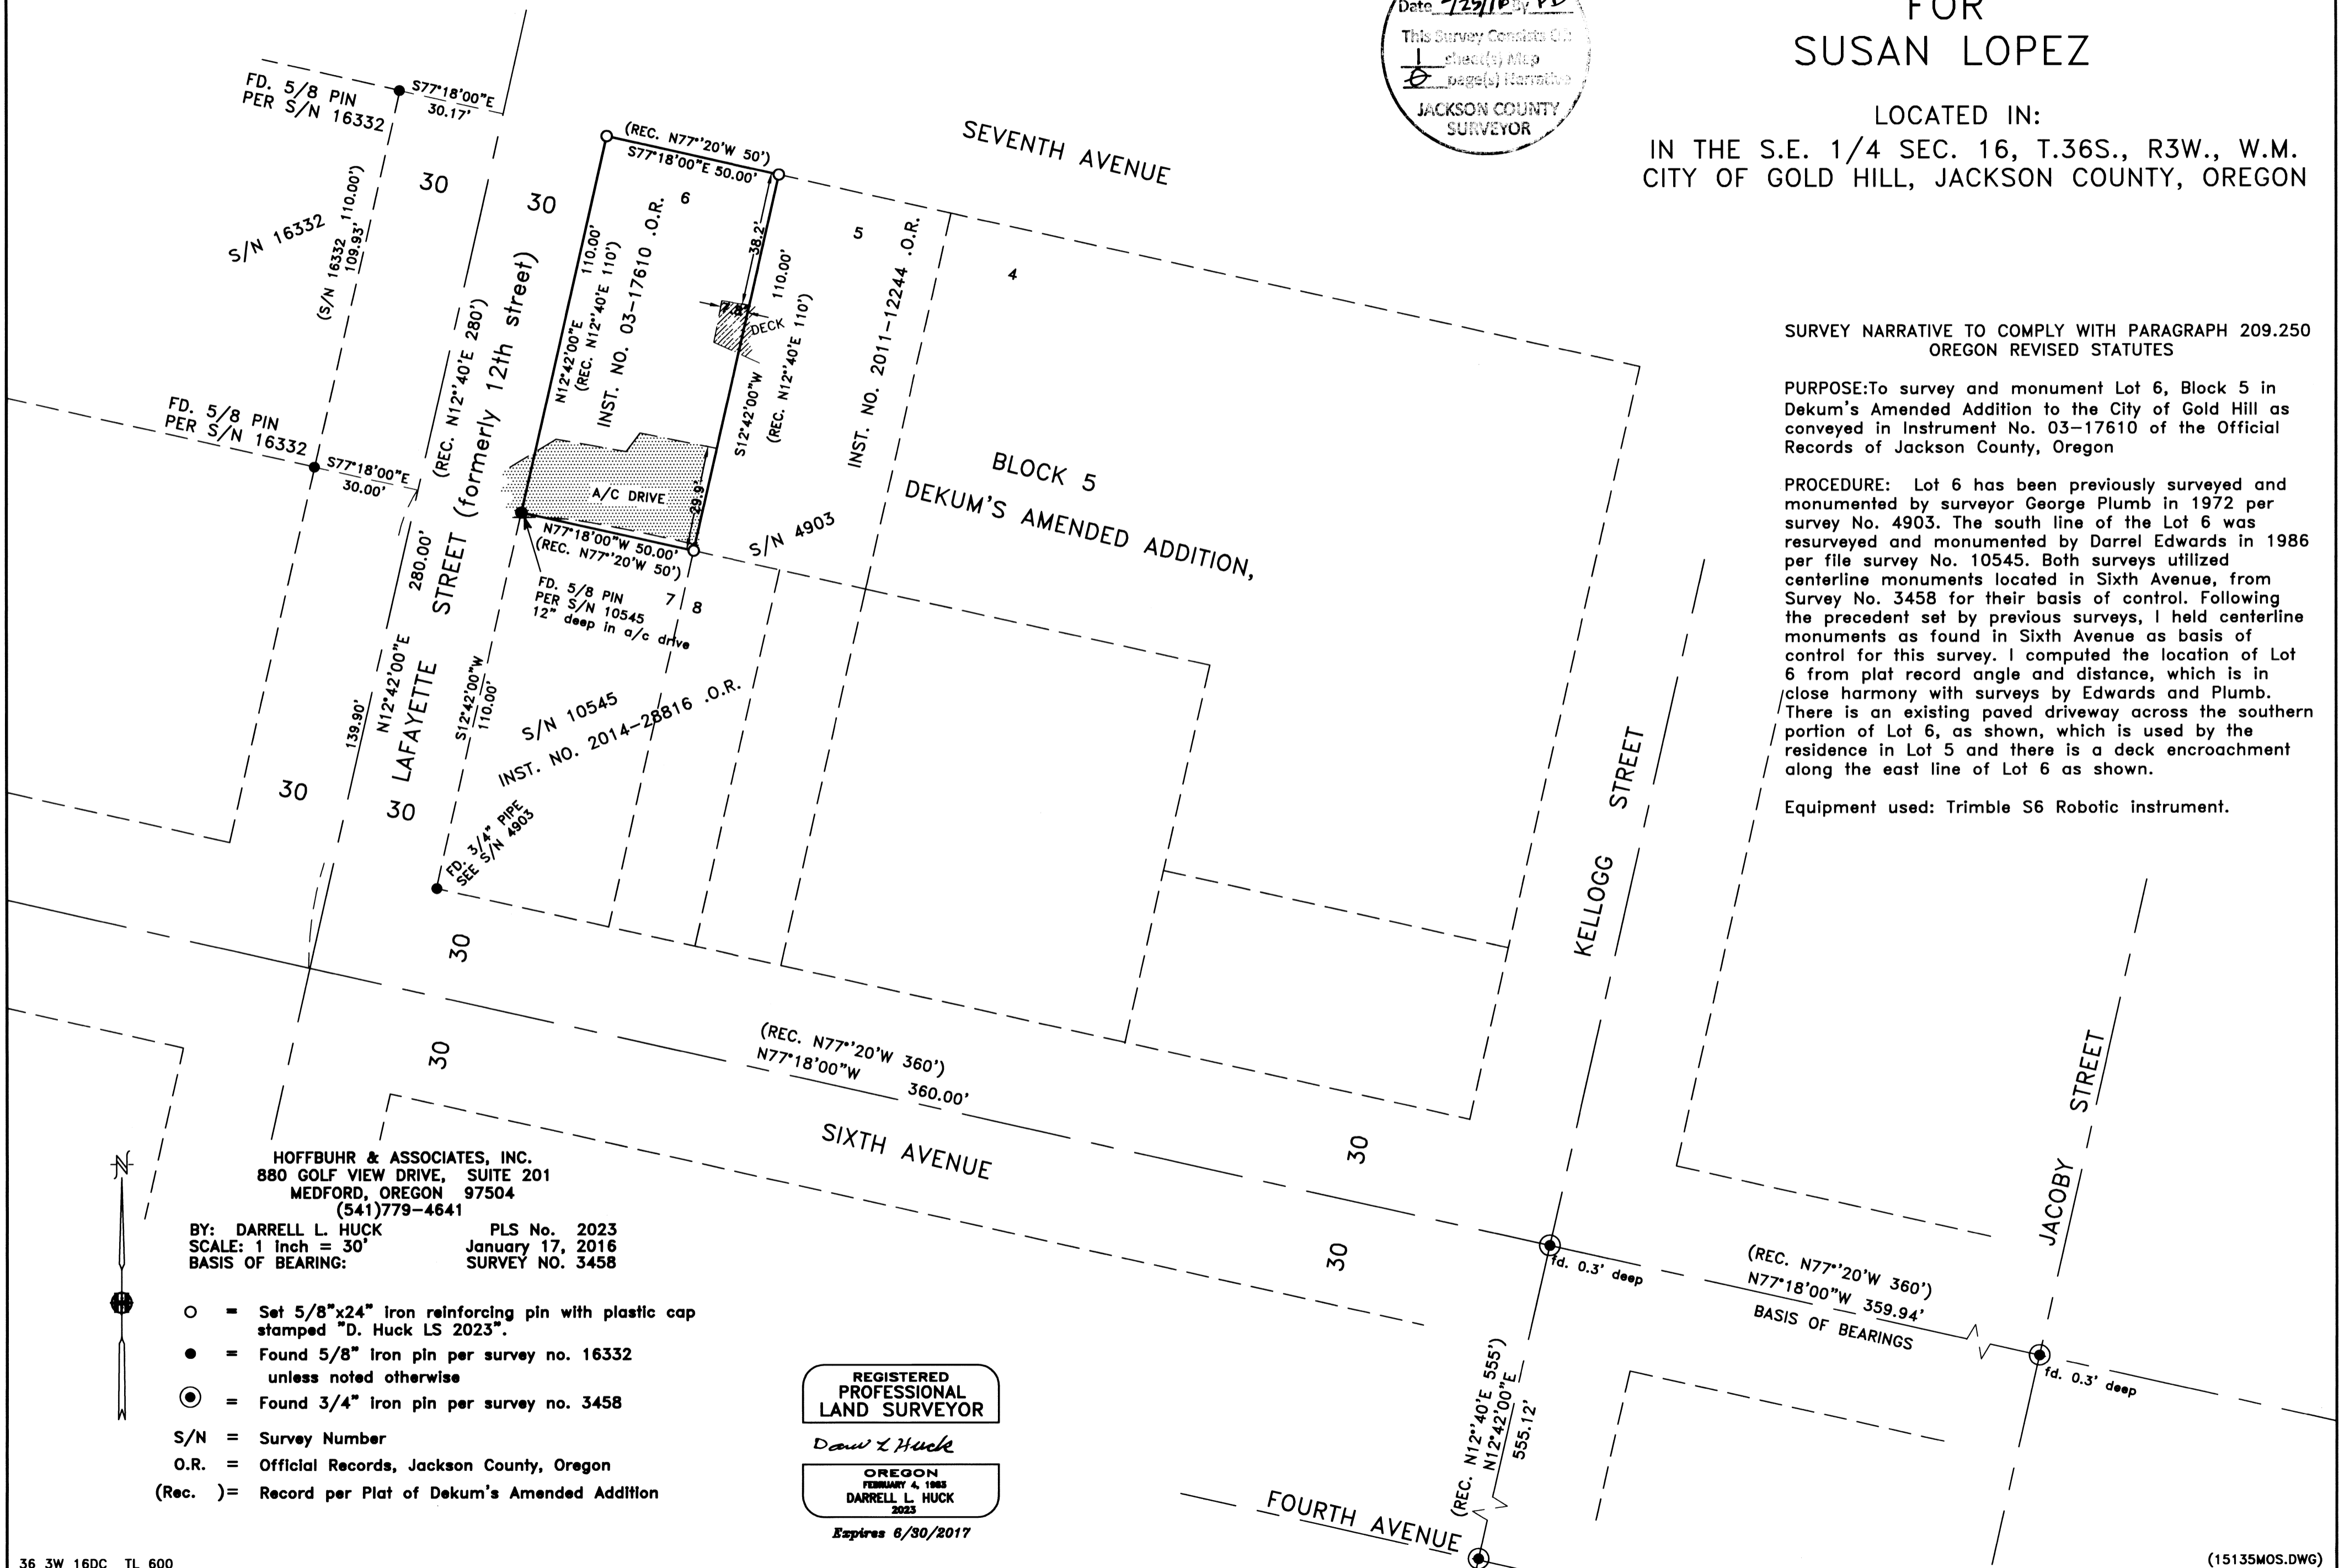

HOFFBUHR & ASSOCIATES, INC.  
 880 GOLF VIEW DRIVE, SUITE 201  
 MEDFORD, OREGON 97504  
 (541)779-4641

BY: DARRELL L. HUCK PLS No. 2023  
 SCALE: 1 inch = 30' January 17, 2016  
 BASIS OF BEARING: SURVEY NO. 3458

- = Set 5/8"x24" iron reinforcing pin with plastic cap stamped "D. Huck LS 2023".
- = Found 5/8" iron pin per survey no. 16332 unless noted otherwise
- ⊙ = Found 3/4" iron pin per survey no. 3458
- S/N = Survey Number
- O.R. = Official Records, Jackson County, Oregon
- (Rec. ) = Record per Plat of Dekum's Amended Addition

REGISTERED  
 PROFESSIONAL  
 LAND SURVEYOR

*Darrell L. Huck*

OREGON  
 FEBRUARY 4, 1983  
 DARRELL L. HUCK  
 2023

Expires 6/30/2017