

# MAP OF SURVEY

**SURVEY FOR:**

Great Plains Trust  
 Charles & Kathleen Vanderpool, Trustees  
 P.O. Box 14531  
 Albuquerque, NM. 87191

**SURVEY BY:**

Kaiser Surveying  
 19754 Highway 62  
 Eagle Point, OR. 97524

**LOCATION:**


S.E. 1/4 of Section 33,  
 T.34S., R.1W., W.M.,  
 Jackson County, Oregon

**DATE:**

April 26, 2016

**LEGEND**

- o = Found 5/8" Rebar  
S.N. 6795
- = Found 5/8" Rebar  
S.N. 4120
- = Set 5/8" x 30" Rebar  
with Plastic Cap marked  
"B. KAISER RLS 52923"
- S.N. = Filed Survey Number  
County Surveyors Office
- C.S. = County Surveyor
- E.P.I.D. = Eagle Point Irrigation District
- ( ) = Record/S.N. 11379
- (( )) = Record/S.N. 6795
- (( ( ))) = Record/S.N. 21447
- (( ( ( ))) = Record/S.N. 4120
- x-x- = Fence

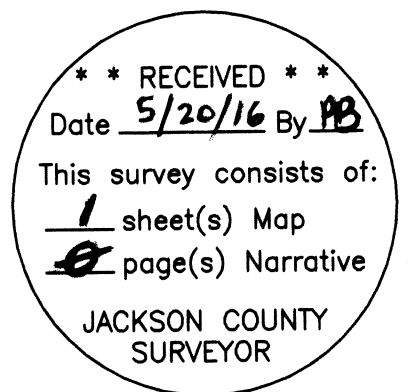

**SURVEY NARRATIVE TO COMPLY WITH O.R.S. 209.250**

**PURPOSE:** Boundary Survey of the tract described as Parcel F in Instrument No. 2014-009002 O.R..

**PROCEDURE:** Equipment used to perform survey was a Nikon DTM-522 total station. The subject property is described as an aliquot part of Section 33 in Township 34 South, Range 1 West, being that portion of the North Half of the Southwest quarter of the Southeast quarter lying Southerly of Hammel Road. A subdivision of the Southeast quarter of Section 33 was performed by making survey ties to government corners as shown on the annexed map. Survey ties were made to the Southeast corner of said Section 33 by this office while conducting work on Filed Survey Nos. 19526 and 21447, it appears that this corner has been affected by poor soil conditions and possibly by fence construction in the area. On this survey I used the location as tied by this office on Filed Survey No. 19526. Hammel Road right-of-way was located by found monuments and information from Filed Survey No. 6795. I computed and monumented the subject property boundaries as shown hereon.


REGISTERED  
**PROFESSIONAL  
 LAND SURVEYOR**

*Bary D. Kaiser*

OREGON  
 JULY 15, 2003  
 BARY D. KAISER  
 No. 52923  
 EXP. 6-30-17

**CURVE TABLE**

Δ	R	L	LC
① 27°14'13"	410.737'	195.25'	N76°20'47"E, 193.42'
② 5°39'10"	410.737'	40.52'	N65°33'16"E, 40.51'
③ 62°29'27"	328.099'	357.85'	N31°28'57"E, 340.37'
④ 6°59'29"	328.099'	40.035'	N59°13'56"E, 40.01'

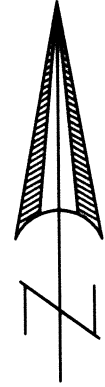

SCALE: 1" = 200'

1/4 CORNER  
 1" IRON PIPE WITH  
 BRASS CAP EXP. 2"  
 (C.S. 1989)

