21994

MAP OF SURVEY

Located In:

THE S.E.1/4 OF SECTION 31, T. 37 S., R. 2 W., W.M.
CITY OF JACKSONVILLE, JACKSON COUNTY, OREGON

For:

CAROL OLSON
1350 Chatham Court
Pleasanton, Ca. 945766

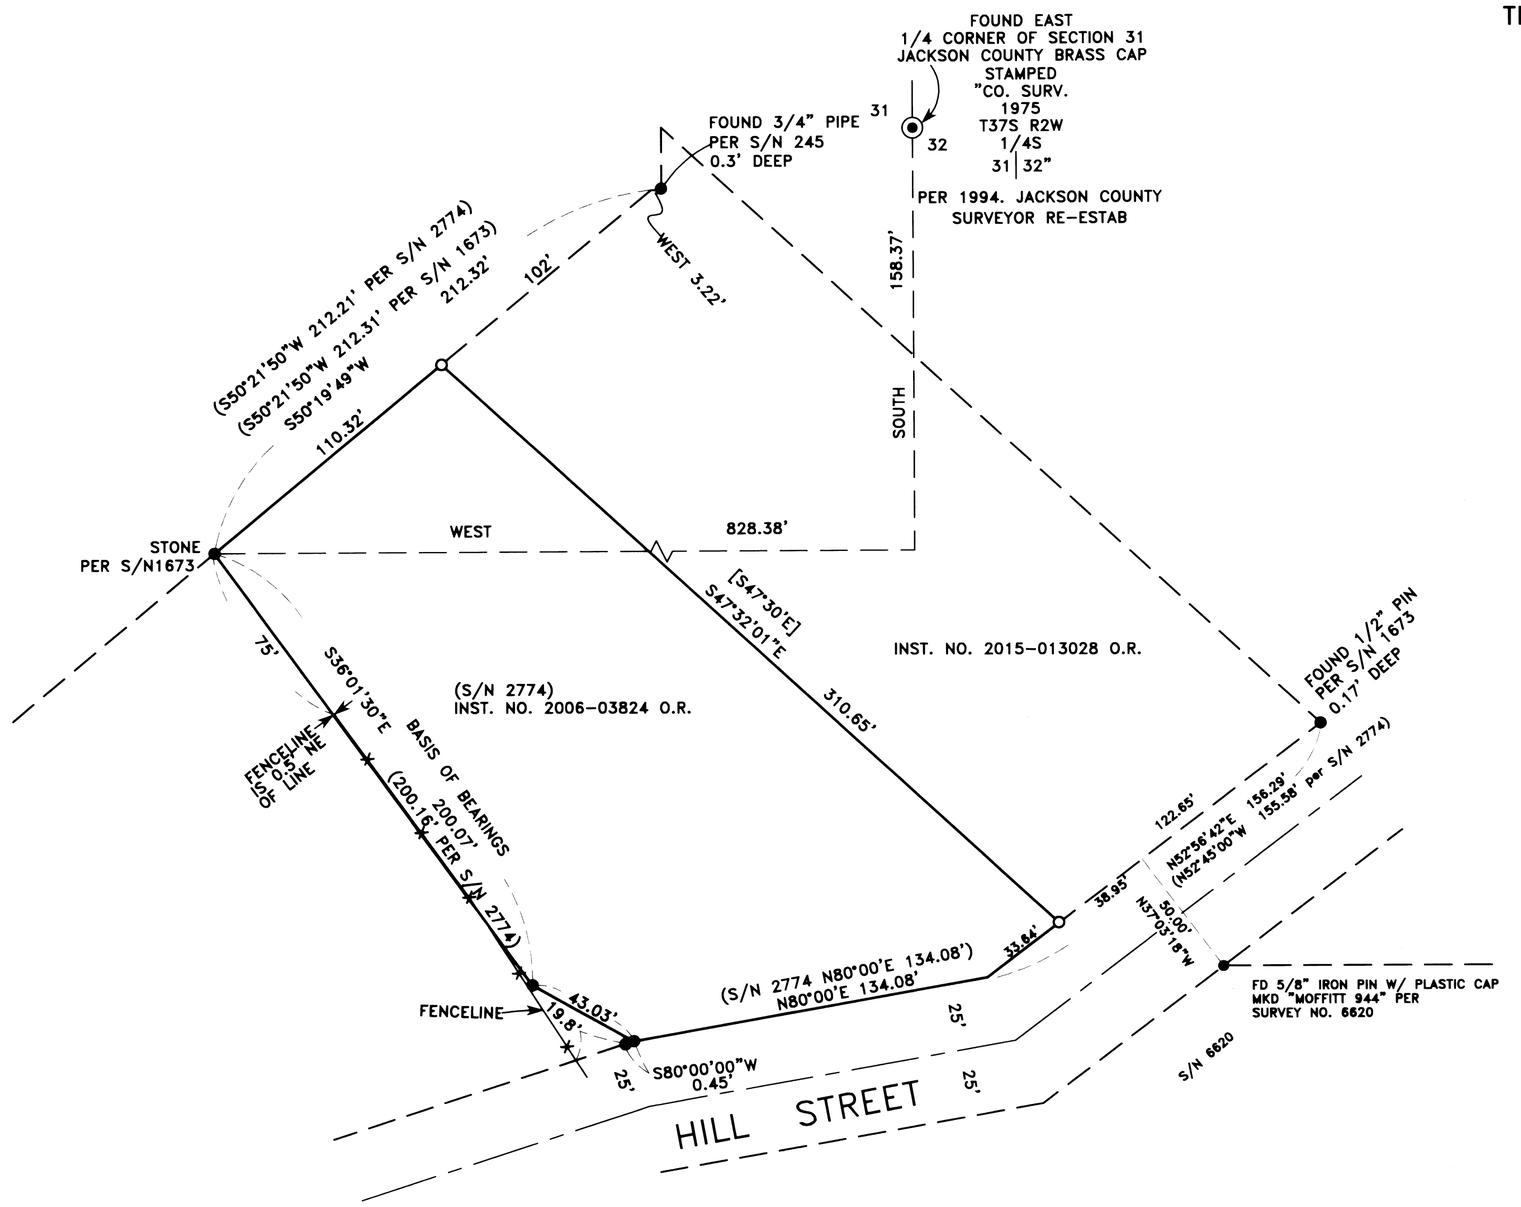

SURVEY NARRATIVE TO COMPLY WITH PARAGRAPH 209.250
OREGON REVISED STATUTES

PURPOSE:To survey and monument the easterly line of the property described in Instrument No. 2006-03824 of the Official Records of Jackson County, Oregon

PROCEDURE: The northerly and westerly boundary of the property has been previously surveyed per filed survey No. 19296. Monuments as shown on that survey were located and held for control. The northerly property corner was set at deed record distance from a stone, which stone has been tied and is identified on survey No. 19296. The southerly property corner was computed at deed record angle from the north boundary to intersect the north line of Hill Street. The location of Hill Street was determined from found monuments per surveys No. 1673, 6620 and 19296.

Equipment used: Trimble S6 Robotic instrument.

RECEIVED
Date 6/1/16 By PB
This survey Consists of:
1 sheet(s) Map
0 pages(s) Narrative
JACKSON COUNTY
SURVEYOR

REGISTERED
PROFESSIONAL
LAND SURVEYOR

Darrell L Huck

OREGON
FEBRUARY 4, 1985
DARRELL L. HUCK
2023

Expires 6/30/2017

HOFFBUHR & ASSOCIATES, INC.
880 GOLF VIEW DRIVE, SUITE 201
MEDFORD, OREGON 97504
(541)779-4641

BY: DARRELL L. HUCK — PLS No. 2023
SCALE: 1 inch = 40' — April 7, 2016
BASIS OF BEARING: — Survey No. 19296

○ = Set 5/8"x24" iron reinforcing pin with plastic cap stamped "D. Huck LS 2023".

● = Found 5/8" iron pin per Survey No. 19269 unless noted otherwise

◉ = Found brass cap monument

O.R. = Offical Records, Jackson County, Oregon

S/N = Survey Number

[-] = Record per instrument No. 2006-038324

15104mos.dwg)
SHEET 1 OF 1

37 2W 31D T.L. 700

21994