
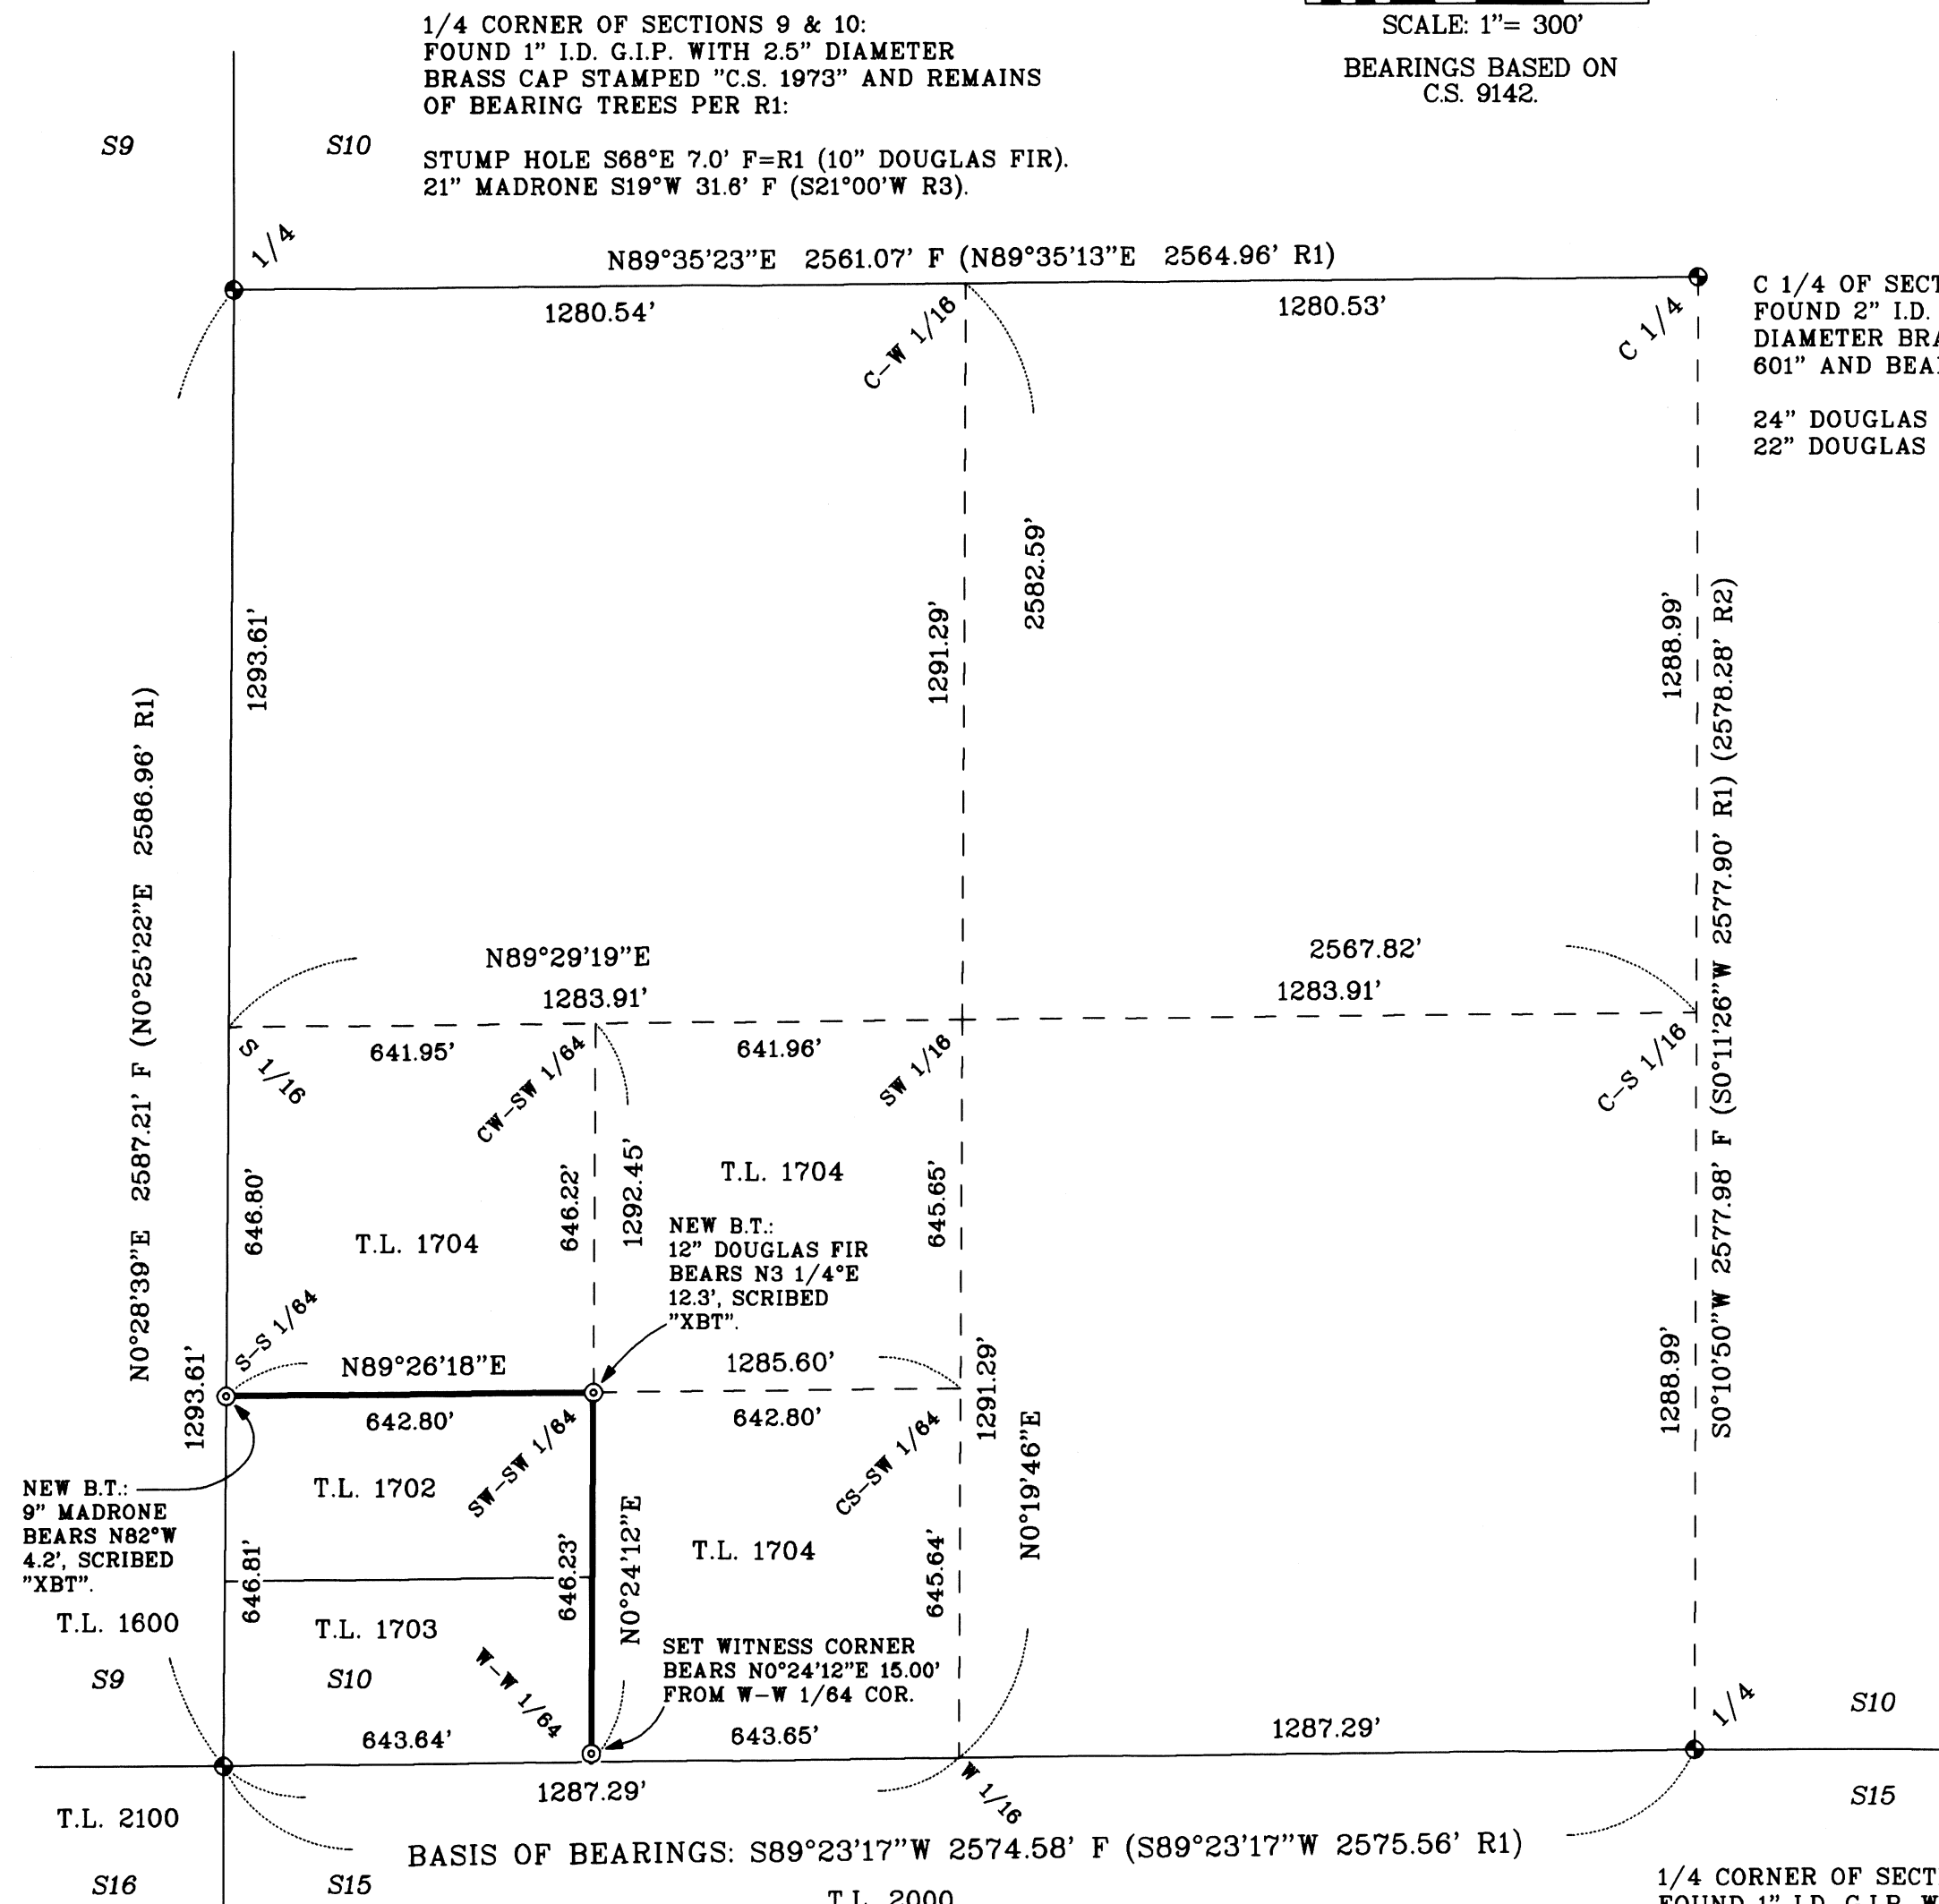
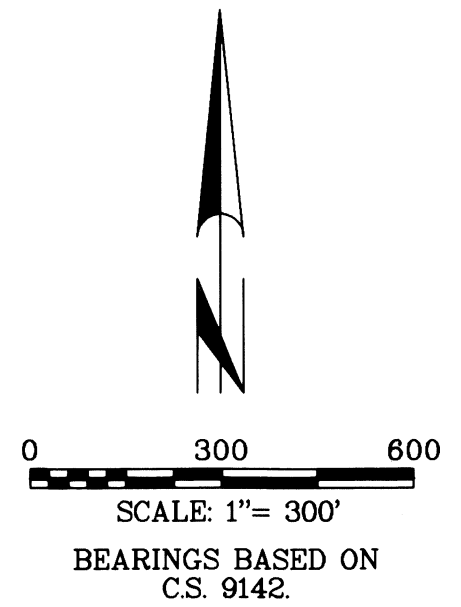


REFERENCES:

R1 = C.S. 9142
 R2 = C.S. 20094
 R3 = CORNER RECORD 10831

LEGEND OF SYMBOLS & ABBREVIATIONS

- ⊙ SET 5/8" IRON ROD WITH 2" DIAMETER ALUMINUM CAP STAMPED "PLS 77662".
- FOUND MONUMENT AS NOTED.
- F FIELD MEASUREMENT
- G.I.P. GALVANIZED IRON PIPE
- I.D. INSIDE DIAMETER
- T.L. TAX LOT
- () INDICATES RECORD DATA
- D.N. DOCUMENT NUMBER
- C.S. COUNTY FILED SURVEY

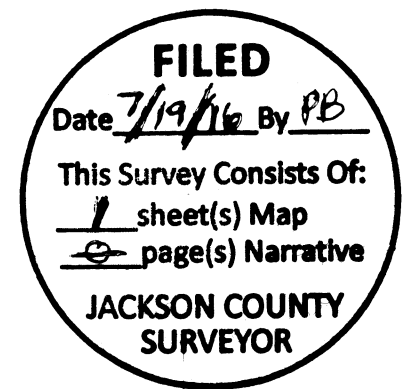

SURVEY NARRATIVE:

THE PURPOSE OF THIS SURVEY IS TO MONUMENT AND BLAZE THE PORTION OF TAX LOT 1704 BOUNDARIES SHOWN IN BOLD HEREON.

USING SHOWN FOUND 1/4 CORNERS AND SECTION CORNERS, I SURVEYED THE SW1/4 OF THE SW1/4 OF THE SW1/4 OF SECTION 10, AS DESCRIBED IN DEED FOR TAX LOTS 1702 AND 1703 (D.N. 90-23805), ACCORDING TO THE BLM MANUAL OF INSTRUCTIONS, 2009.

THIS ALIQUOT PART OF SECTION 10 IS AN EXCEPTION TO THE DESCRIPTION FOR TAX LOT 1704 AND IS DESCRIBED CORRECTLY IN D.N. 84-12515. HOWEVER IT IS INCORRECTLY DESCRIBED IN THE NEXT TWO DEEDS IN THE CHAIN OF TITLE (D.N. 2004-060209 & D.N. 2009-048259).

THIS SURVEY WAS CONDUCTED USING A TOPCON GTS 3003W TOTAL STATION AND TOPCON HIPER STATIC GPS RECEIVERS. THE FIELD SURVEY COMMENCED JUNE 8, 2016 AND WAS COMPLETED JUNE 9, 2016.

CORNER OF SECTIONS 9, 10, 15, & 16:
 FOUND 2" I.D. G.I.P. WITH 2.5" DIAMETER BRASS CAP STAMPED "RPLS 601" AND BEARING TREES PER R1:
 19" DOUGLAS FIR N49°25'E 37.5' F=R1.
 18" DOUGLAS FIR S48°20'E 34.9' F=R1.
 12" DOUGLAS FIR S64°55'W 14.1' F (25.2' R1).
 8" DOUGLAS FIR N59°44'W 21.25' F=R1.

1/4 CORNER OF SECTIONS 10 & 15:
 FOUND 1" I.D. G.I.P. WITH 2.5" DIAMETER BRASS CAP STAMPED "C.S. 1973" AND BEARING TREES PER R3:
 14" MADRONE N7°45'E 15.1' F=R3.
 24" WHITE FIR, DEAD & DOWN, S59°50'E 19.1' F=R3.
 20" DOUGLAS FIR S86°W 17.4' F=R3.

REGISTERED PROFESSIONAL LAND SURVEYOR

Gregg Arnold Neitsch
 OREGON
 JULY 11, 2006
 GREGG ARNOLD NEITSCH
 77662LS
 EXPIRES: 12/31/2016

MAP OF SURVEY

FOR
C.V. SHELDON FAMILY LIMITED PARTNERSHIP
 IN THE SOUTHWEST QUARTER OF SECTION 10, T. 40 S., R. 1 W., W.M., JACKSON COUNTY, OREGON
 NORTH STATE LAND SURVEYING
 1511 KYLYNN CT.
 MOUNT SHASTA, CA
 JUNE 2016 SCALE: 1"=300' SHEET 1 OF 1
 SHELDMAP.ASC SHELDON ROS.GXD JOB NO. 426