

Survey No. 2209

SURVEY NARRATIVE TO COMPLY WITH PARAGRAPH 209.250, OREGON REVISED STATUTES

FOR: ELK LUMBER COMPANY

PURPOSE: To rehabilitate and perpetuate the 1/4 Section corner common to Sections 10 and 11, Township 33 South, Range 1 East, W.M.

PROCEDURE:

Found the remains of the Northwest BT which is a White Oak stub badly decayed, but with reversed scribe "BT" showing in callus tissue. The original Southeast BT is now a down White Oak snag showing old axe work but with all scribing obliterated. Also found an unrecorded BT apparently scribed about 15 years ago and an apparently unmarked stone, 9 inches by 12 inches by 6 inches, at the approximate position of the corner.



I removed a transit hub from the corner position and set in its place a 1 inch by 3/4 inch steel pipe driven 30 inches in the ground and capped with a 1-1/2 inch to 1 inch galvanized bell reducer filled with pot metal and stamped as shown below in 1/8 inch letters and numerals:

1963  
T 33 S  
R 1 E  
10 - 11  
1/4 COR  
RS 583

From this monument the unrecorded BT which is a 13 inch Ponderosa Pine, double blazed and scribed "1/4 S" in the upper blaze and "BT" in the lower, bears North 58° East 11.9 feet to face of lower blaze; and a 13 inch Incense Cedar, double blazed and scribed "RS 583" in the upper blaze and "BT" in the lower, bears South 19°00' West 24.6 feet to face of lower blaze.

Compass Variation set at 20°00' East.

Field work by Robert M. Vincent and John L. Gartman.

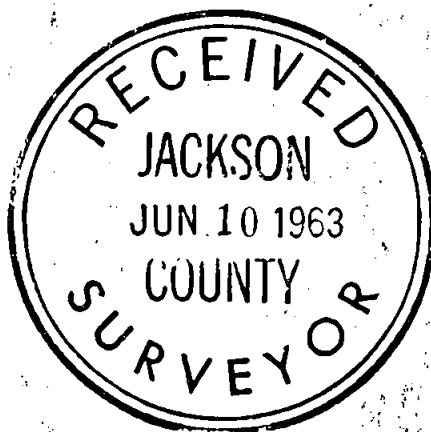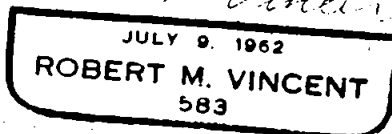

May 20, 1963