


**MAP OF SURVEY**  
**PROPERTY LINE ADJUSTMENT**  
 LOCATED IN

PARCEL 2 OF PARTITION PLAT NO. P-87-1995 (TAX LOT 200)  
 AND TAX LOT 100, ALL IN NW 1/4 OF SEC. 29, T 36 S, R 4 W, W.M.  
 JACKSON COUNTY, OREGON  
 MAY 30, 2016

JACKSON COUNTY DEVELOPEMENT SERVICES (FILE NO. 439-16-00036-SUB)  
 APPROVED BY *Francisco Alvarez* DATE *Dec. 15, 2016*

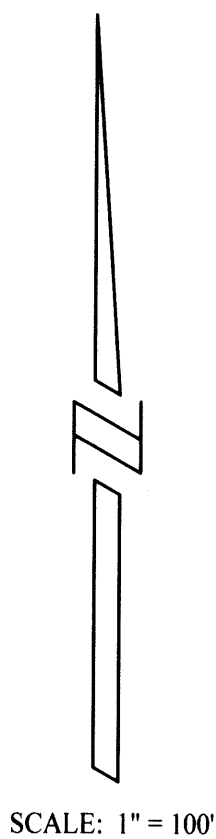

CENTERLINE OF 50 FT. WIDE  
 PRIVATE ROAD ACCESS EASEMENT  
 PER PARTITION PLAT P-87-1995

PARCEL 4  
 CUL-DE-SAC  
 PER P-87-1995

FD. 5/8" I. ROD  
 PER C.S. 21021

PARCEL 1  
 S 90°00'00" W  
 (S 90°00'00" W)

PARCEL 2  
 INTERMITTENT

ADJUSTED TAX LOT 100  
 11.96 ACRES +/-  
 INST. NO. 2016-~~2016-041266~~ J.C.O.R.

NOT SURVEYED THIS SURVEY

| Id | ADJ. LINE Bearing | Distance |
|----|-------------------|----------|
| L1 | S 62°33'04" E     | 32.44'   |
| L2 | S 34°53'25" E     | 43.40'   |
| L3 | S 35°19'22" E     | 64.56'   |
| L4 | S 44°54'46" E     | 47.44'   |
| L5 | S 46°24'16" E     | 54.96'   |
| L6 | S 22°28'15" E     | 51.85'   |
| L7 | S 36°30'45" E     | 68.67'   |
| L8 | S 36°24'26" E     | 45.18'   |
| L9 | S 02°24'50" E     | 42.26'   |

REGISTERED  
 PROFESSIONAL  
 LAND SURVEYOR

*Raymond W. Wytcherley*

OREGON  
 JULY 25, 1995  
 RAYMOND W. WYTCHERLEY  
 2724  
 EXPIRES JUNE 30, 2018

**FILED**  
 Date *12/15/16* By *SW*  
 This Survey Consists Of:  
 1 sheet(s) Map  
 2 page(s) Narrative  
 JACKSON COUNTY  
 SURVEYOR

SURVEYED FOR:  
 DAMEON LEE POOL  
 PO BOX 5716  
 GRANTS PASS, OR 97527

SURVEYED BY:  
 RAYMOND WYTCHERLEY  
 WYTCHERLEY SURVEYING  
 P.O. BOX 888  
 GLENDALE, OR 97442  
 541-660-2648

**NARRATIVE:**  
 THE PURPOSE OF THIS SURVEY IS TO ADJUST THE PROPERTY  
 LINE BETWEEN THE PROPERTY DESCRIBED IN INSTRUMENT  
 NO. 2012-032012, JACKSON COUNTY OFFICIAL RECORDS  
 (TAX LOT 100) AND PARCEL 2 OF PARTITION PLAT NO. P-87-1995  
 (TAX LOT 200). I FOUND AND HELD THE MONUMENTS AS  
 SHOWN ON THIS MAP. THIS SURVEY WAS PERFORMED USING  
 A DTM-A5 NIKON TOTAL STATION WITH A TDS RECON DATA  
 COLLECTOR.

- LEGEND:**
- INDICATES 5/8" x 30" I. ROD W/YEL. PLASTIC CAP MARKED "LS 2724 WYTCHERLEY" SET THIS SURVEY.
  - INDICATES MONUMENT FOUND AS INDICATED.
  - △ INDICATES CALCULATED POINT.
  - ( ) INDICATES RECORD AS INDICATED.
  - [ ] INDICATES RECORD PER C.S. 14742, (P-87-1995).
  - { } INDICATES RECORD PER C.S. 21021.
  - J.C.O.R. INDICATES JACKSON COUNTY OFFICIAL RECORDS.
  - BASIS OF BEARINGS PER C.S. 21021.