


Map of Survey

Located in : T38S, R2W, NE1/4 and SE1/4 Section 6 , W.M.
Jackson County, Oregon

**** RECEIVED ****
 DATE 12/14/16 BY PB
 This survey consists of:
1 sheet(s) Map
0 page(s) Narrative
 JACKSON COUNTY SURVEYOR

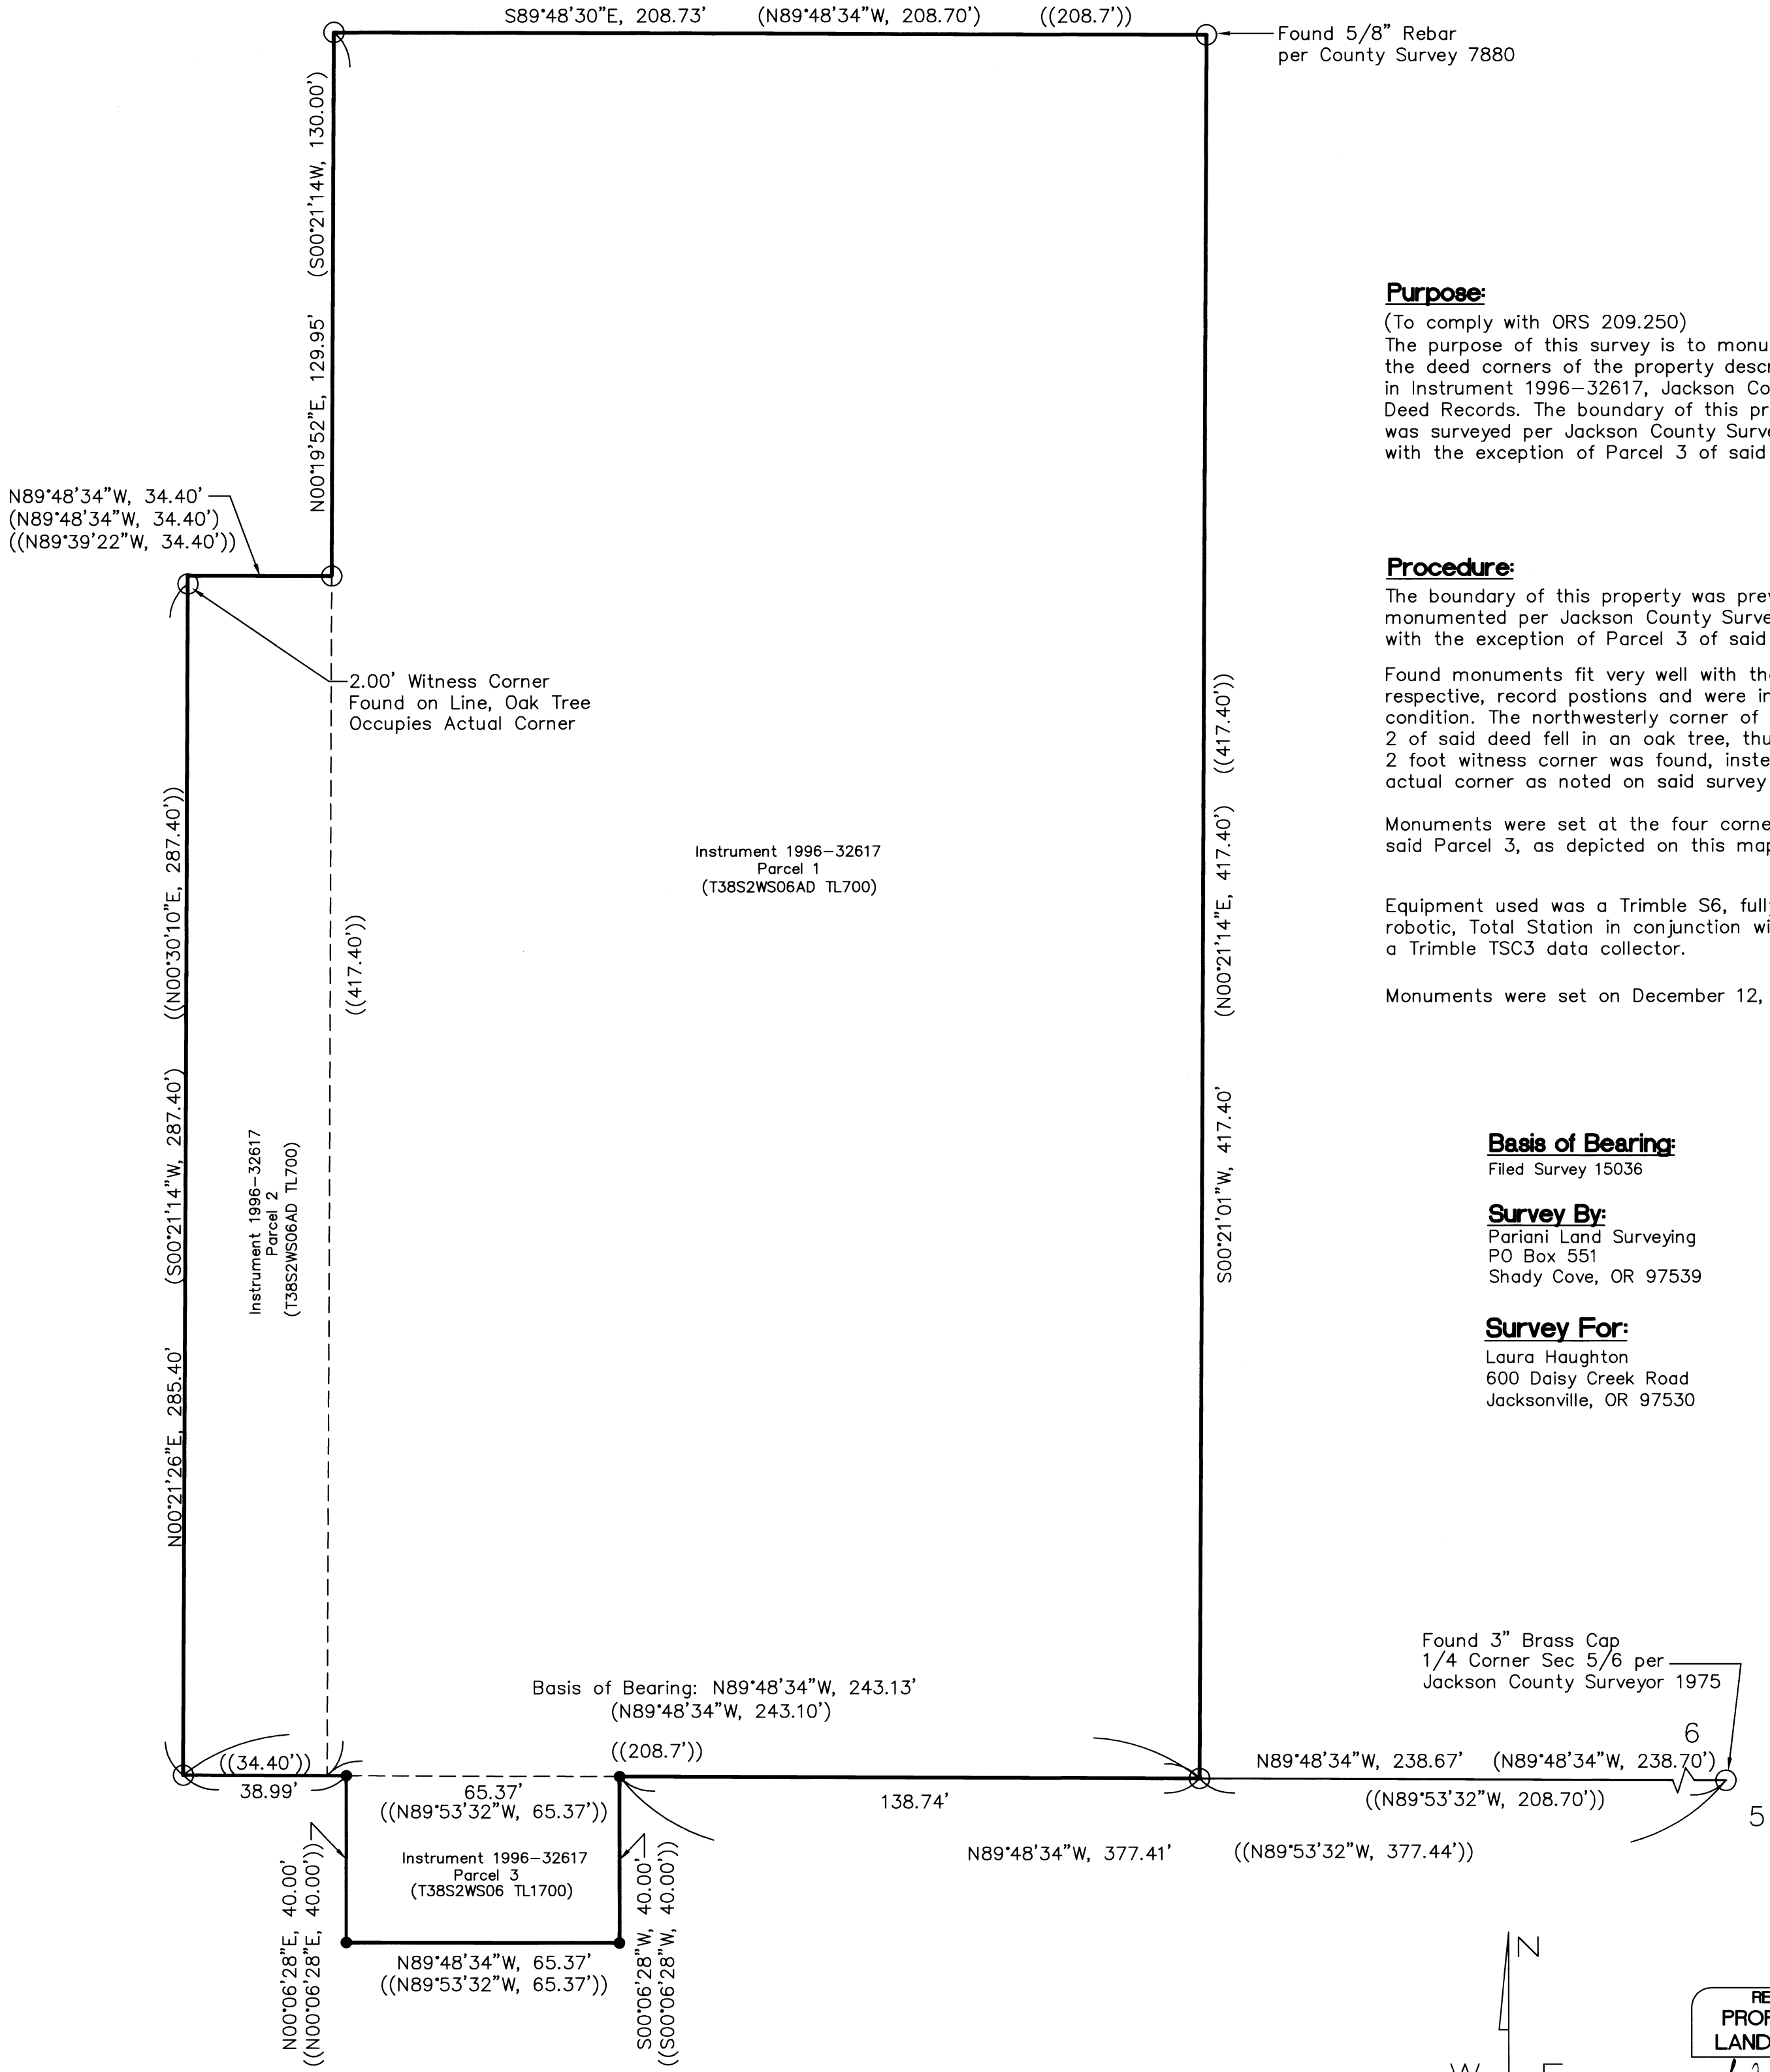

Purpose:

(To comply with ORS 209.250)
 The purpose of this survey is to monument the deed corners of the property described in Instrument 1996-32617, Jackson County Deed Records. The boundary of this property was surveyed per Jackson County Survey 15036, with the exception of Parcel 3 of said deed.

Procedure:

The boundary of this property was previously monumented per Jackson County Survey 15036, with the exception of Parcel 3 of said deed.

Found monuments fit very well with their respective, record positions and were in good condition. The northwesterly corner of Parcel 2 of said deed fell in an oak tree, thus a 2 foot witness corner was found, instead of the actual corner as noted on said survey 15036.

Monuments were set at the four corners of said Parcel 3, as depicted on this map.

Equipment used was a Trimble S6, fully robotic, Total Station in conjunction with a Trimble TSC3 data collector.

Monuments were set on December 12, 2016.

Basis of Bearing:

Filed Survey 15036

Survey By:



Pariani Land Surveying
 PO Box 551
 Shady Cove, OR 97539

Survey For:

Laura Houghton
 600 Daisy Creek Road
 Jacksonville, OR 97530

Legend:

- Found 2" aluminum cap marked "SPERO LS2309" per Filed Survey 15036, Unless Noted Otherwise
- Set 5/8"x30" Rebar with Plastic Cap "PARIANI LS51382"
- () Record data per Filed Survey 15036, Jackson County Surveyor
- (()) Record data per Instr. No. 1996-32617, Jackson County Deed Records
- Existing Property Line
- - - - Parcel Limits per Instr. No. 1996-32617

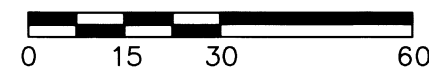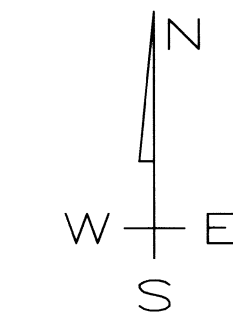

REGISTERED
 PROFESSIONAL
 LAND SURVEYOR

John R. Pariani
 OREGON
 July 13, 1999
 JOHN R. PARIANI
 #51382
 Renews: December 31, 2018

Map of Survey

Pariani Land Surveying

PO Box 551
 Shady Cove, OR 97539
 541-890-1131 ParianiLS@yahoo.com

Date: Dec. 16, 2016	Scale: 1" = 30'	Job No.: 2016-333	Sheet: 1 of 1
------------------------	--------------------	----------------------	------------------

T38S, R2W, S06, TL 1700
 T38S, R2W, S06ad, TL 700