

FS INDEX ID: P-21

CORNER INVESTIGATION REPORT

CORNER: 1/4 **GCDB ID:** 600340 **DATE:** 12/6/16
TOWNSHIP: 40 S **STATE:** OREGON
RANGE: 2 W **COUNTY:** JACKSON
SECTION: 23 & 24 **FOREST:** RR-S
MERIDIAN: W.M. **DISTRICT:** SIS. MOUNTAIN
NFSL PROPERTY BOUNDARY CORNER?: YES NO
LINE(S) POSTED: UNKNOWN UNKNOWN
MAINTAINED: 1990 NORTH 1990 SOUTH
GUARD POST(S): SOUTH 2.4 FT

CORNER HISTORY:

(1883) - ESTABLISHED CORNER, SETS STONE & TWO BT'S.
(1965) - FINDS STONE DISTURBED AND TWO BT'S. RESETS STONE
(1975) - FINDS STONE & 2 BT'S, SETS IRON POST/BRASS CAP & MARKS 2 NEW BT'S.
(1990) - FINDS BLM BRASS CAP & 3BT'S.
(2008) - FINDS BLM BRASS CAP, 2 ROOTHOLES AND 2 BT'S. & MARKS 2 NEW BT'S.

MONUMENT FOUND/SET:

FOUND A 2 1/2 INCH DIAMETER GALVANIZED IRON PIPE WITH A 3 1/4 INCH BLM BRASS CAP PROJECTING 4 INCHES ABOVE A MOUND OF STONE.

RECORD CORNER ACCESSORIES:

A 19" WINDTROWN FIR WITH HEALED DOUBLE BLAZE
NO TRACE OF A (ROOT HOLE) 2008
A 22" W.FIR WITH A HEALED SINGLE BLAZE
A 15" W.FIR WITH A HEALED SINGLE BLAZE
A 16" W.FIR WITH A HEALED DOUBLE BLAZE
A 16" W.FIR WITH A PARTIALLY HEALED DOUBLE BLAZE

NEW CORNER ACCESSORIES:

NONE

CORNER MAINTENANCE/OTHER INFO:

CLEAR BRUSH FROM AROUND MONUMENT AND TO BT'S. TIE FLAGGING TO MONUMENT AND GUARD POSTS, PAINT BT FACES & A 6" BAND AT HEAD HEIGHT,

GEODETTIC COORDINATES:

LATITUDE: N 42°04.593'
LONGITUDE: W 122°53.683'
ELLIPSOID HEIGHT: 4941 FT
DATUM: WGS84

SOURCE: HANDHELD GPS

DATE OF INVESTIGATION: 10/25/16

REPORT BY: ANDREW HILLMAN, SURVEY TECH.

ASSISTED BY: JACOB HUNT, SURVEY TECH.

DOCUMENTS ON FILE AT:

3106 PIERCE PARKWAY, STE. D
SPRINGFIELD, OREGON 97477

HISTORY OF VISITATIONS:

1883 - RUFUS S. MOORE, GLO SURVEY
1965 - JACK A. BRUMF, FS CORNER CARD
1975 - R.D. AANRUD, BLM REMON
1975 - HAROLD L. CENTER, SUBDIVISION
1990 - JIM BICHELL, FS CORNER CARD
2008 - R. ROBERTS, COUNTY SURVEYOR

REGISTERED
PROFESSIONAL
LAND SURVEYOR

John Ransom

OREGON
JULY 21, 1992
JOHN C. RANSOM
2561

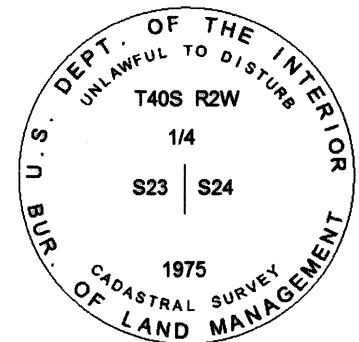
EXPIRES: 12/31/2018

RECORD MEASUREMENTS:

(N33°W - 10.6 FT)1883, (N31°20'W)1975
(S82°E - 11.2 FT)1883, (S84°E)1975
(S34-1/2°E - 40.6 FT)1975
(S10°W - 33.7 FT)1975
(N58°E - 15.3 FT)2008
(N73-1/4°W - 14.9 FT)2008

METHOD OF MEASUREMENT:

NO NEW MEASUREMENTS TAKEN.

CAP DIAGRAM:

THIS DOCUMENT FILED IN CS OFFICE:

YES

OTHER DOCUMENT FILED WITH CS: