

FS INDEX ID: N-19

CORNER INVESTIGATION REPORT

CORNER: 1/4
TOWNSHIP: 40 S
RANGE: 2 W
SECTION: 14 & 23
MERIDIAN: W.M.
NFSL PROPERTY BOUNDARY CORNER?: YES NO

GCDB ID: 540400
STATE: OREGON
COUNTY: JACKSON
FOREST: RR-S
DISTRICT: SIS. MOUNTAIN

DATE: 12/5/16**HISTORY OF VISITATIONS:**

1883 - RUFUS S. MOORE, GLO SURVEY
 19xx - C.B. WOODSELL, FS CORNER CARD
 1975 - R.D. AANRUD, BLM RESURVEY
 1979 - C.T. DAVIDSON, FS CORNER CARD
 1993 - F.W. COOK, CSF# 13796
 1994 - G. KAISER, CSF# 13850
 1994* - S.M. OSMUS, CSF# 13928

LINE(S) POSTED: EAST-1978 WEST-1979**MAINTAINED:** EAST-2016 WEST-1991**GUARD POST(S):** EAST 4.4 FT**CORNER HISTORY:**

(1883) - ESTABLISHED CORNER, SETS STONE & 2 BT'S.
 (19xx) - UNDATED, FINDS STONE & 2 BT'S, OPENS ONE BT TO VERIFY CORNER.
 (1975) - FINDS STONE & 2 BT'S, SETS IRON POST/BRASS CAP & 2 NEW BT'S.
 (1979) - FINDS BLM BRASS CAP & 4 BT'S.
 (1993), (1994) & (1994*) - FINDS BRASS CAP, NO NOTE OF BT'S.

MONUMENT FOUND/SET:

FOUND A 2 1/2 INCH DIAMETER GALVANIZED IRON PIPE WITH A 3 1/4 INCH BRASS CAP PROJECTING 2 INCHES ABOVE A COLAR OF STONE.

RECORD CORNER ACCESSORIES:

A ROTTEN FIR STUMP, SIZE INDETERMINATE, BEARS N0°18'E - 6.2 FT, WITH NO MARKS VISIBLE.
 A 24" SNAG NEARS S10°10'E - 10.6 FT, WITH A SINGLE HEALED BLAZE
 NO TRACE FOUND OF A (16" FIR)1975
 A ROTTEN FIR STUMP, SIZE INDETERMINATE, BEARS S61°05'W - 25.8 FT, WITH NO MARKS VISIBLE.

NEW CORNER ACCESSORIES:

A NEW 6" CEDAR MARKED "1/4S14" "BT" ON A SINGLE BLAZE BEARS N77°33'E - 14.9 FT
 A NEW 6" CEDAR MARKED "X" "BT" BEARS N50°31'W - 14.1 FT
 A NEW 6" FIR MARKED "X" "BT" BEARS S13°14'W - 14.0 FT
 A NEW 9" FIR MARKED "1/4S23" "BT" ON A DOUBLE BLAZE, BEARS S39°19'E - 49.2 FT

CORNER MAINTENANCE/OTHER INFO:


CLEAR BRUSH FROM AROUND MONUMENT AND TO BT'S. TIE FLAGGING TO MONUMENT AND GUARD POSTS, PAINT BT FACES & A 6" BAND AT HEAD HEIGHT,

GEODETIC COORDINATES:

LATITUDE: N 42°05.020'
LONGITUDE: W 122°54.273'
ELLIPSOID HEIGHT: 3730
DATUM: WGS84

SOURCE: HANDHELD GPS**DATE OF INVESTIGATION:** 10/25/16**REPORT BY:** ANDREW HILLMAN, SURVEY TECH.**ASSISTED BY:** JACOB HUNT, SURVEY TECH.**DOCUMENTS ON FILE AT:**

3106 PIERCE PARKWAY, STE. D
 SPRINGFIELD, OREGON 97477

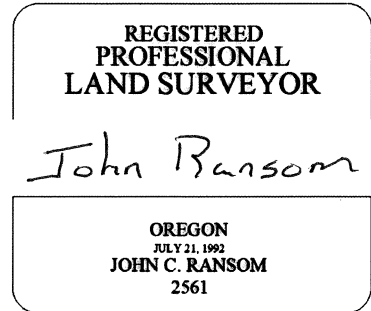

EXPIRES: 12/31/2018

RECORD MEASUREMENTS:

(N5°E - 5.9 FT)1883


(S13°E - 11.9 FT)1883

(N57°30'E - 33.7 FT)1975

(S57°30'W - 26.4 FT)1975

METHOD OF MEASUREMENT:

LEICA TCRA 1103+ TOTAL STATION.
 BEARING BASED ON PROPERTY
 LINE POST 123.5 FT DIST. SET BY
 FRED W. COOK, RPLS 2439, IN 1996.
 DISTANCES TO BEARING TREES
 MEASURED TO AN ALUMINUM NAIL
 SET AT SIDE CENTER

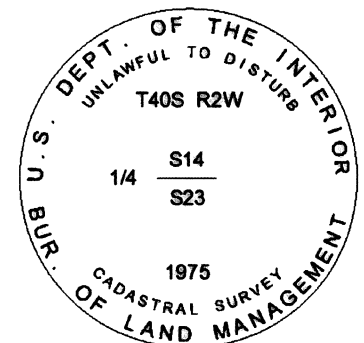CAP DIAGRAM:**THIS DOCUMENT FILED IN CS OFFICE:**

YES

OTHER DOCUMENT FILED WITH CS: