


RECEIVED
 JACKSON
 JUL 9 1963
 COUNTY
 SURVEYOR

SURVEY IN SEC. 20, 21, 28 & 29 T. 36 S., R. 1 W., W.M.
 FOR
 BUD HOOVER
 57-13 MERRY LANE

BY EDWARD A. MC GINTY
 MEDFORD
 MAY 1963

SCALE 1" = 200'
 ○ = 1/2" I. PIN FD
 ○ = 5/8" I. PIN
 □ = CONC. MON. FD.

REGISTERED
 OREGON
 LAND SURVEYOR
 Edward A. McGinty
 JULY 1958
 EDWARD A. MCGINTY
 301

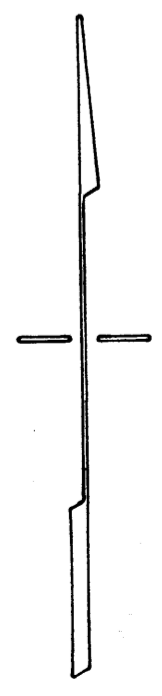

Survey No. 2218

Survey Narrative to comply with O. R. S. 209-250:

Survey for: Bud Hoover

Survey by: Edward A. McGinty, L.S.
5/2/63

BASIS OF BEARING: Merry Lane of Agate Sub-division Ext. No. 1.


PRECEDENCE OF SURVEY:

Found monuments along the south line of Agate Sub-division inconsistent with records as shown, also the north line of Lake Shore Drive. The west line of Lake View Drive extension was extended to a 5/8 inch iron pin at the southeast corner of Tract M-11. The iron pin set at this point by James Clabby had been removed by adjacent owners and replaced on this survey. From RP's Cramer Drive was produced southerly from iron pin found on Agate Sub-division.

Iron pins were found along the south line of Agate Sub-division Ext. No.

2; iron pins along the east line of Agate Sub-division Ext. No. 1

were found. Divided tracts as shown as requested by Mr. Hoover.

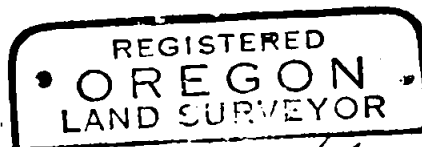

Edward A. McGinty
JULY 10, 1963
EDWARD A. MCGINTY
301

