

MAP OF SURVEY

A DEPENDENT SURVEY for  
Weyerhaeuser South Valley Timberlands  
within SECTION 18, and the  
S.1/2 of SECTION 7, T38S R3E, W.M.  
as situated in  
JACKSON COUNTY, OREGON  
June 23, 2017

**BASIS OF BEARING**  
The North line of the NE.1/4  
of Section 18, as determined  
by the BLM (see SR-3)

**FILED**  
Date 8/28/17 By PB  
This Survey Consists Of:  
2 sheet(s) Map  
9 page(s) Narrative  
JACKSON COUNTY  
SURVEYOR

**NARRATIVE**

The purpose of this survey was to mark certain boundary lines within the S.1/2 of Section 7 and within Section 18, T38S R3E, for Weyerhaeuser South Valley Timberlands. In 1977, the BLM performed an "Administrative Survey" of Section 13, T38S R2E (see SR-2), at which time the 1/16th corners along the West line of Section 18, T38S R3E were established. Also in 1977, the BLM performed "Administrative Surveys" in Sections 18 and 19, T38S R3E (see SR-4 & 5), at which time the C.1/4 corner of Section 18 was set. Then in 1979, the BLM performed an "Administrative Survey" of the S.1/2 of Section 7, T38S R3E (see SR-3), at which time all the 1/16th corners were established. During this survey, all the controlling corners were found and accepted as shown and described hereon.

This survey was conducted from April-June of 2017. The control traverses were ran with a "Leica TS06+" total station, obtaining a relative accuracy of over 1:20,000. The Weyerhaeuser boundary lines were then marked with 1/2"x6" white fiber glass rods, painted blazes and flagging, as indicated hereon. All corner references were measured to the side center of the tree. All new references added during this survey also have a brass shiner stamped "LS-2069" nailed to the scribed face. No new corners were established during this survey.


**LEGEND**

- = A corner FOUND or established during a previous survey, as described
- = A new monument re-established during this survey, consisting of a 5/8" x 30" rebar with yellow plastic survey cap, stamped "HAMPSTUR CORP. LS 2069"
- ( ) = A Bearing and/or Distance of record
- GIP = A Galvanized Iron Pipe
- GLO = U.S. General Land Office (original survey)
- BLM = U.S.D.I. Bureau of Land Management
- R/C = A rebar w/plastic surveyor's cap, as described
- WEY-CO = Weyerhaeuser Company, South Valley Timberlands
- SR [X] = Survey Reference No.
- REF-POST = A 6' steel fence post w/location tag
- ▬▬▬▬▬▬ = A boundary line marked during this survey with 1/2"x6" white fiber glass rods, painted blazes and orange flagging

**SURVEY REFERENCES (SR)**

- 1) 1983 SURVEY BY R. THOMPSON, LS-1358, CS-9639
- 2) 1977 ADMINISTRATIVE SURVEY BY BLM, CS-6966
- 3) 1979 ADMINISTRATIVE SURVEY BY BLM, OF THE S.1/2 SEC. 7, T38S R3E, ON FILE WITH THE BLM
- 4) 1977 ADMINISTRATIVE SURVEY BY THE BLM, OF SEC. 19, T38S R3E, ON FILE WITH THE BLM
- 5) 1977 ADMINISTRATIVE SURVEY BY THE BLM OF SEC. 18, T38S R3E, ON FILE WITH THE BLM

NOTE: SEE PAGE 2 FOR ALL CORNER DESCRIPTIONS

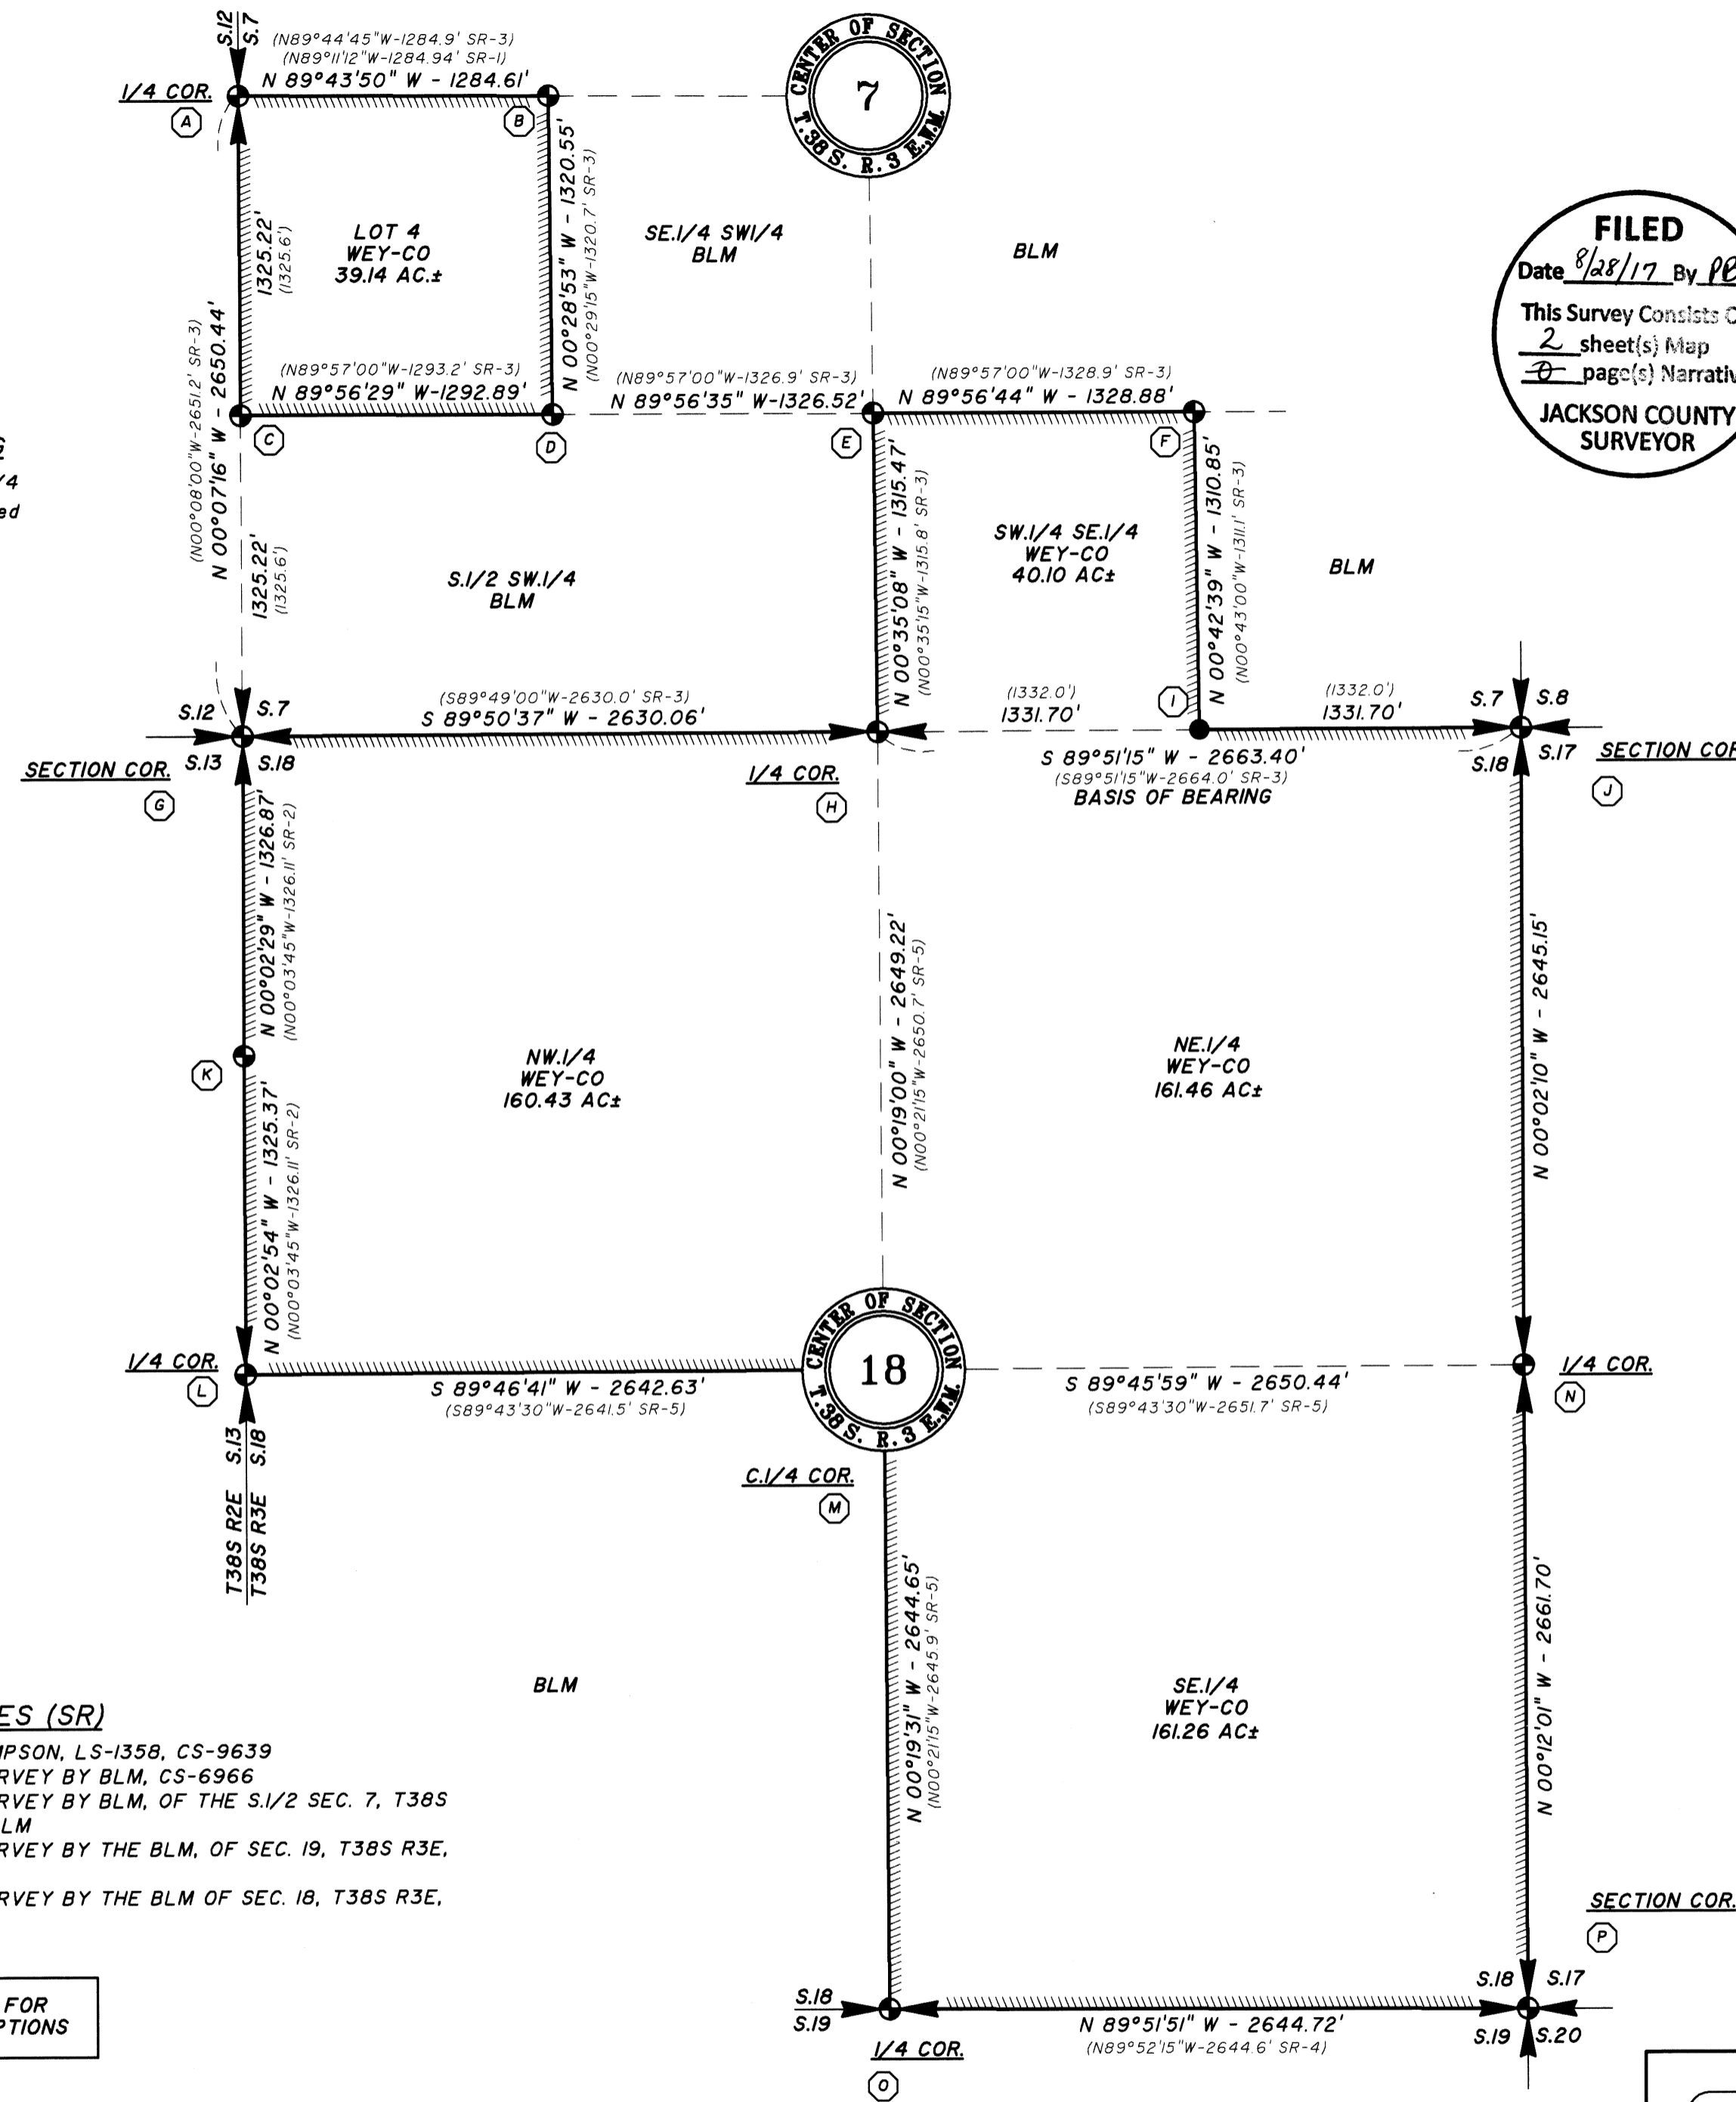


T38S R3E TLI200 & TLI300

REGISTERED PROFESSIONAL LAND SURVEYOR  SIGNED: 8/23/2017 OREGON DECEMBER 2, 1983 CALVIN J. HAMPTON 2069 EXPIRES: 6/30/2019	<b>HAMPSTUR CORPORATION</b> 	
	Calculated by : CJH Checked by : CJH/PRG Drawn by : TLG Completion date : 6/23/2017 Field Book no. : 17-622 Drawing No. : 17-622.DWG HAMPSTUR JOB no. : 17-622 Sheet no. 1 of 2	P.O. Box 368 Kelso, Washington 98626 Phone: (360) 423-8166


**CORNER DESCRIPTIONS for**  
**Survey within SECTIONS 7 & 18, T38S R3E, W.M.**  
**as situated in**  
**JACKSON COUNTY, OREGON**  
**June 23, 2017**

**FILED**  
 Date 8/28/17 By PB  
 This Survey Consists Of:  
2 sheet(s) Map  
1 page(s) Narrative  
**JACKSON COUNTY**  
**SURVEYOR**

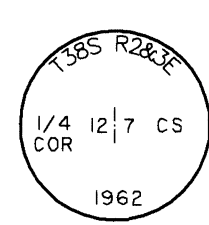


**A 1/4 COR.**  
 Fd. 1" GIP w/stamped brass cap,  
 8" high (see SR-1,3).

- REFERENCES:**  
 -FD. 9" FIR W/HEALED FACES,  
 N.46°E.--6.8'  
 -FD. 24" FIR W/HEALED FACES,  
 S.37°E.--66.6'  
 -FD. 8" FIR W/HEALED FACES,  
 S.47°W.--30.0'  
 -FD. 34" FIR W/HEALED FACE,  
 N.82°30'W.--37.3'  
 -SET REF-POST, SOUTH--3.0'

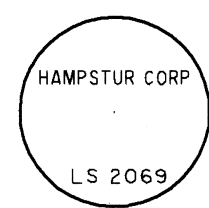


**B CW 1/16 COR.**  
 Fd. 5/8" rebar in a mound of  
 stone, as set in 1979 (see SR-3).  
 Added yellow plastic cap stamped  
 "LS-2069" to rebar.

- REFERENCES:**  
 -FD. 24" FIR W/HEALED FACES,  
 S.69°30'E.--17.3'  
 -FD. 27" FIR W/HEALED FACES,  
 S.70°W.--57.0' (REC.=51.0'). SEE SR-3)  
 -SET REF-POST, SOUTH--3.0'

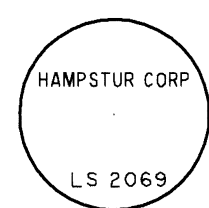


**C S 1/16 COR.**  
 Fd. 5/8" rebar in a mound of  
 stone, as set in 1979 (see SR-3).  
 Added yellow plastic cap stamped  
 "LS-2069" to rebar.

- REFERENCES:**  
 -FD. 9" FIR W/HEALED FACE,  
 S.59°45'E.--7.9'  
 -FD. 46" FIR SNAG, 15' TALL, W/HEALED  
 FACE, N.88°30'W.--11.9'  
 -SET REF-POST, NORTH--3.0'

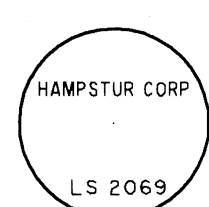


**D SW 1/16 COR.**  
 Fd. 5/8" rebar in a mound of stone, as  
 set in 1979 (see SR-3). Added yellow  
 plastic cap stamped "LS-2069" to  
 rebar.

- REFERENCES:**  
 -FD. 1" IRON PIPE, N.77°30'E.--23.3'  
 (HISTORY UNKNOWN)  
 -FD. 21" FIR W/HEALED FACE,  
 S.33°45'E.--97.4'  
 -FD. 16" FIR SNAG, 3' TALL, N.17°W.--17.7'  
 -SET REF-POST, NORTH--3.0'

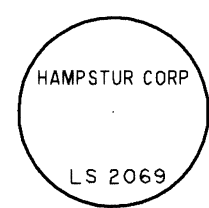


**E CS 1/16 COR.**  
 Fd. 5/8" rebar in a mound of stone, as  
 set in 1979 (see SR-3). Added yellow  
 plastic cap stamped "LS-2069" to  
 rebar.

- REFERENCES:**  
 -FD. 12" FIR W/HEALED FACE, S.71°E.--3.4'  
 -FD. 28" FIR W/HEALED FACE, S.41°W.--42.1'  
 -SET REF-POST, SOUTH--3.0'

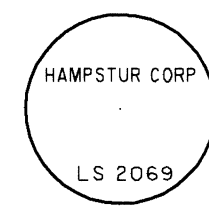


**F SE 1/16 COR.**  
 Fd. 5/8" rebar in a mound of stone, as set  
 in 1979 (see SR-3). Added yellow plastic  
 cap stamped "LS-2069" to rebar.

- REFERENCES:**  
 -18" FIR W/HEALED FACE, N.7°45'W.--11.8'  
 -18" FIR W/HEALED FACE, S.32°W.--18.2'  
 -SET REF-POST, SOUTH--2.0'

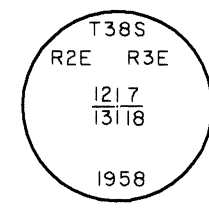


**G SECTION COR.**  
 Fd. 2-1/2" iron pipe w/3" stamped brass cap,  
 5" high (see SR-2,3)

- REFERENCES:**  
 -FD. 15" FIR W/HEALED FACE AND TAG DATED  
 10/06/03, N.26°E.--15.7'  
 -FD. 36" FIR W/HEALED FACE AND TAG DATED 8/56,  
 N.30°W.--18.0'  
 -FD. 26" CEDAR W/HEALED FACE AND TAG DATED  
 10/16/03, S.30°W.--29.4'  
 -FD. 17" FIR W/HEALED FACE, N.7°W.--21.8'  
 -SET REF-POST, SOUTH 3.0'

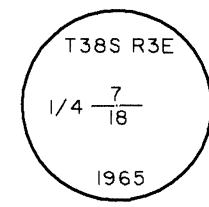


**H 1/4 COR.**  
 Fd. 2-1/2" iron pipe w/3" stamped brass cap,  
 8" high in a mound of stone (see SR-1,3,5)

- REFERENCES:**  
 -FD. 27" FIR W/HEALED FACES, N.38°45'E.--51.8'  
 -FD. 18" FIR W/HEALED FACES, S.48°30'E.--49.2'  
 -FD. 25" FIR W/HEALED FACE, S.62°W.--8.5'  
 -SET REF-POST, NORTH--3.0'

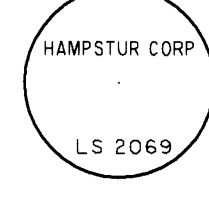


**I E 1/16 COR.**  
 Set a 5/8"x30" rebar with stamped yellow  
 plastic cap "LS-2069" at record location  
 determined from found 1979 BLM references  
 (see SR-3)

- REFERENCES:**  
 -FD. 29" FIR W/HEALED FACE, N.66°45'E.--14.1'  
 -FD. 29" FIR W/HEALED FACE, S.40°E.--54.5'  
 -SET REF-POST, NORTH--3.0'

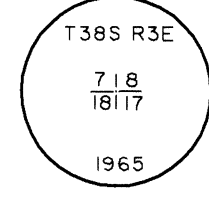


**J SECTION COR.**  
 Fd. 2-1/2" iron pipe w/3" stamped brass cap, 6"  
 high in a mound of stone (see SR-3)

- REFERENCES:**  
 -FD. 23" FIR W/ HEALED FACE, N.75°E.--35.6'  
 -FD. 12" FIR W/VIS. SCRIBE (T38SR3ES17BT), S18°E.--51.0'  
 -FD. 10" FIR W/VIS. SCRIBE (T38SR3ES18BT), S.29°W.--8.4'  
 -FD. 14" YEW W/VIS. SCRIBE (EBT), N.68°W.--21.6'  
 -SET REF-POST, WEST--3.0'

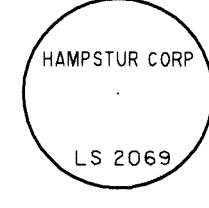


**K N 1/16 COR.**  
 Fd. 5/8" rebar in a mound of stone, as set in 1977  
 (see SR-2). Added yellow plastic cap stamped  
 "LS-2069" to rebar.

- REFERENCES:**  
 -FD. 25" FIR W/HEALED FACES, N.79°E.--17.9'  
 -FD. 13" FIR W/HEALED FACES, N.89°W.--52.0'  
 -SET REF-POST, SOUTH--3.0'

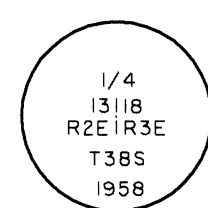


**L 1/4 COR.**  
 Fd. 2-1/2" iron pipe w/3" stamped brass cap,  
 12" high (see SR-2)

- REFERENCES:**  
 -FD. 10" FIR W/HEALED FACES, N.44°E.--44.7'  
 -FD. 17" CEDAR W/HEALED FACE, S.18°30'E.--23.8'  
 -FD. 8" FIR W/HEALED FACES, S.31°30'W.--38.3'  
 -FD. 18" FIR W/HEALED FACE, N.46°W.--47.5'  
 -SET REF-POST, EAST--3.0'

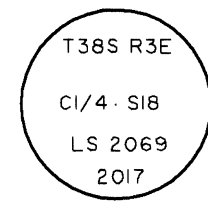


**M C 1/4 COR.**  
 Fd. 5/8" rebar in mound of stone as set by the  
 BLM in 1977 (see SR-5). Added a 2" stamped  
 aluminum cap to rebar.

- REFERENCES:**  
 -FD. 30" FIR W/HEALED FACE, S.18°W.--56.9'  
 -FD. 21" FIR W/HEALED FACE, N.72°45'E.--50.5'  
 -SET (NEW BT) 7" CEDAR, BARK SCRIBED (X) (BT),  
 N.70°E.--6.0'  
 -SET (NEW BT) 11" CEDAR, SCRIBED (C1/4S18BT),  
 S.20°E.--8.5'  
 -SET REF-POST, NORTH--3.0'

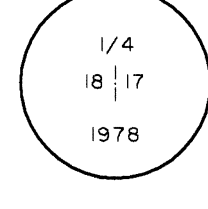


**N 1/4 COR.**  
 Fd. 2-1/2" iron pipe w/3" stamped brass  
 cap, 8" high (see SR-5)

- REFERENCES:**  
 -FD. 28" FIR W/HEALED FACE, N.63°W.--50.5'  
 -FD. 28" FIR W/HEALED FACE, S.63°E.--14.3'  
 (REC.=9.6')  
 -FD. REF-POST, NORTH--0.3'  
 -SET REF-POST, SOUTH 3.0'

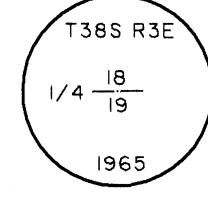

**O 1/4 COR.**  
 Fd. 2-1/2" iron pipe w/3" stamped brass  
 cap in a mound of stone (see SR-4,5)

- REFERENCES:**  
 -FD. 25" FIR W/HEALED FACE, N.41°W.--22.8'  
 -SET (NEW BT) 5" FIR, SCRIBED (1/4S18BT),  
 N.13°W.--28.0'  
 -SET (NEW BT) 11" FIR, SCRIBED (X)(BT),  
 S.57°E.--21.5'  
 -SET (NEW BT) 14" FIR, SCRIBED (1/4S18BT),  
 S.17°E.--8.3'  
 -SET REF-POST, NORTH--2.0'

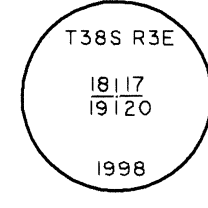

**P SECTION COR.**  
 Fd. 1" iron pipe w/2-1/2" stamped brass  
 cap, 5" high in a mound of stone (see  
 SR-4)

- REFERENCES:**  
 -FD. 11" OAK W/HEALED FACES, N.39°15'W.--44.9'  
 -FD. 10" OAK W/HEALED FACES, S.33°W.--23.5'  
 (REC.=27.3')  
 -FD. 6" OAK W/HEALED FACES, N.87°45'E.--26.6'  
 -FD. 7" OAK W/VIS. SCRIBE (X)(BT),  
 S.72°45'E.--40.1'  
 -FD. REF-POST ON SW. SIDE OF MONUMENT

REGISTERED  
 PROFESSIONAL  
 LAND SURVEYOR  
  
 OREGON  
 DECEMBER 2, 1983  
 CALVIN J. HAMPTON  
 2069  
 EXPIRES: 6/30/2019

**HAMPSTUR CORPORATION**

Calculated by : CJH  
 Checked by : CJH/PRG  
 Drawn by : TLG  
 Completion date : 6/23/2017  
 Field Book no. : 17-622  
 Drawing No. : 17-622.DWG  
 HAMPSTUR JOB no. : 17-622  
 Sheet no. 2 of 2

P.O. Box 368  
 Kelso, Washington 98626  
 Phone: (360) 423-8166