

2238

WITNESS CORNER


(REC. N 72° 00' E)
N 72° 02' 30" E 130.00'

10.34'

(REC. N 11° 00' W) 110.00'
(REC. N 11° 00' W) 258.07'
(REC. N 11° 00' W) 15.99'

(REC. S 18° 10' E 303.00') 304.18'
S 19° 03' 10" E 319.01'

N.W. COR. D.L.C. 50
FD. 2" G.I.P.
T. 37 S., R. 1 W., W.M.

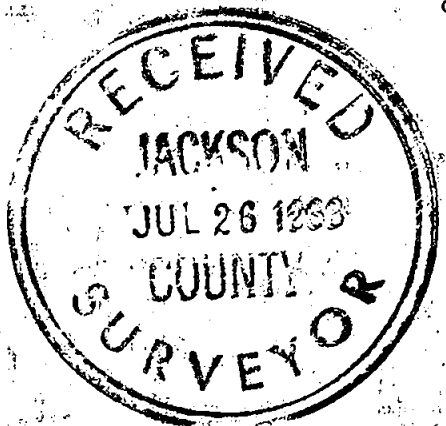

REGISTERED
OREGON
LAND SURVEYOR
Leland P. Lovejoy
NOVEMBER 18, 1949
LELAND P. LOVEJOY
262

FD. 3/4" I. BOLT 0.10' 147.50' 147.50' 688.00'
S 89° 59' 30" W 835.50' (REC. S 89° 57' W)

BARNETT ROAD

60'

60'

FD. 5/8" I. PIN SURV. # 1841

FD. 5/8" I. PINS SURV. # 1841

S.S.E. COR. D.L.C. # 44
FD. 3" BRASS CAP MON.

BOUNDARY SURVEY OF PROPERTY
SITUATE IN
D.L.C. NO. 44, SEC. 31, T. 37 S., R. 1 W., W.M.
JACKSON COUNTY OREGON
FOR
JAMES H. O'BRIEN
L.P. LOVEJOY L.S., MEDFORD, OREGON
SCALE: 1" = 100' MAY 21, 1963
BEARINGS PER SURV. # 1841
O = SET 5/8" IRON PIN

2238

SURVEY NARRATIVE TO COMPLY WITH SECTION 87-3301947 OREGON STATE LAWS

Survey For: James H. O'Brien
1002 South Holly Street
Medford, Oregon

Purpose of Survey: To establish property boundaries and
set corners on property being sold.

Survey Location: D. L. C. No. 44, Section 31, Township 37
South, Range 1 West, Willamette Meridian,
Jackson County, Oregon.

Survey Procedure: Found D. L. C. corners and other survey
monuments, as shown on map, and used as
basis for survey control. Set 5/8" iron
pins, as shown on map.

Leland P. Lovejoy
Registered Land Surveyor

Work completed May 21, 1963

