


2246

P.I. found

SURVEY FOR MR. HARRY ELMORE 839 E. MAIN MEDFORD  
Located S.E. 1/4 SEC. 19, T 37S. R. 1W. JACKSON COUNTY, ORE.

JULY 1963

Scale 1"=40'

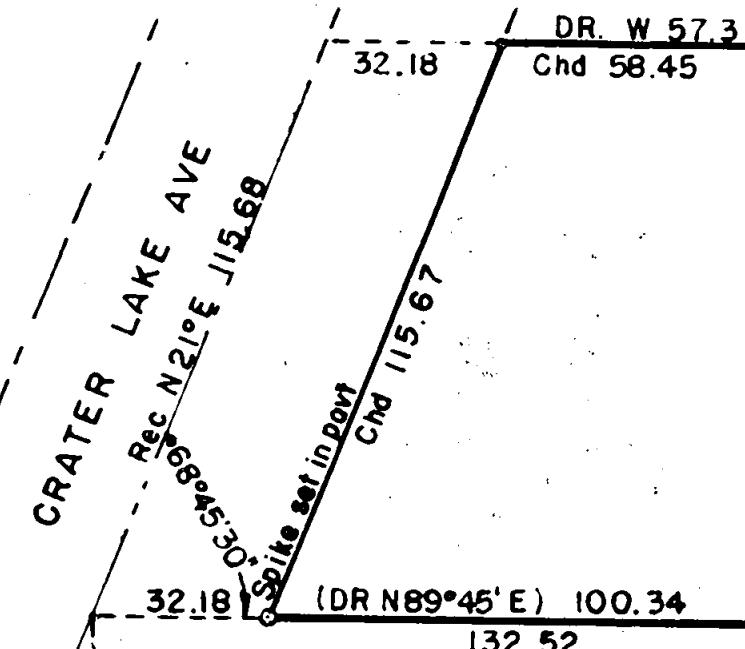


REGISTERED  
OREGON  
LAND SURVEYOR

MAY 6, 1949  
L. N. DOW  
251

D.R. 541-131

Bolt f.

STEVENS ST

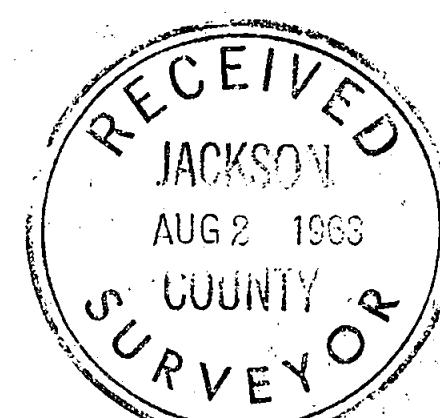

N.E. END L.C. No. 42

2246

Written narrative to accompany plat for Survey NO. 2246

Survey for Mr. Harry Elmore, 839 E. Main Street, Medford, Oregon.  
Made July 1963.

Purpose: to stake out corners of property known as Kimmey's  
Corner at Crater Lake Avenue and Stevens Street.  
in the City of Medford, Jackson County, Oregon.

Procedure:

Found the monument for the Northeast Ell of Donation Land Claim No. 42, and found the point of intersection bar on Crater Lake Avenue for the curve to the north of the D.L.C. making positive location of the Street line.

We then ran on the above tangent line northerly from the D.L.C. corner 103.58 feet to intersect the northerly line of Stevens Street, then ran easterly along the northerly line of Stevens Street 132.52 to the point of beginning of the original deed description, at which point we set a 5/8" bar, we then ran North 107.88 feet and set a 5/8" iron Bar, we then intersected the highway right of way line at a point 58.45 feet west of the above bar, and at a point 115.67 feet northerly from the southwest corner of this tract, at which intersection we set a 5/8" iron bar.

The intersection of Crater Lake Avenue (easterly line) with the north line of Stevens Street we set a spike as this point falls out in the pavement.

