


2254

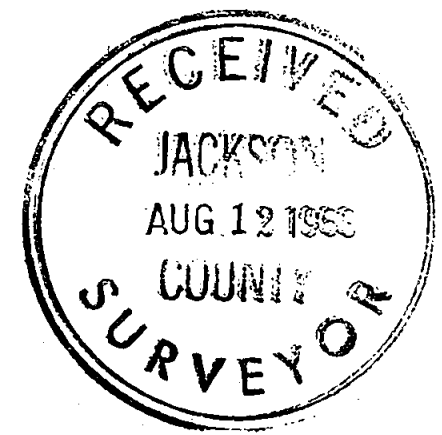

MAP OF SURVEY  
 FOR  
 DAVID L. CURTIS, 563 N. MAIN, ASHLAND, ORE.  
 SITUATE  
 SECTION 31, T. 39S. R. 2E., W.M. OREGON  
 DATE: JULY, 1963  
 SOLAR DATUM



2" IRON PIPE  
 N.W. COR.  
 SEC. 31

1321.80'

N.W. 1/16 COR.

1128.67'

N. 89° 51' E.

1958.96'  
 830.29'

SCALE: 1" = 100'

N. 0° 05' 25" W.

1321.80'

INDICATE IRON PIPES FD.  
 SET.

SEE RECORDED SURVEY  
 THIS TRACT

W 1/4 COR.

SEC. 31

3/4" IRON PIPE

S. 89° 51' W. 821.90'  
 738.37'

S. 2° 29' E. 235.41'

SOUTHERN PACIFIC R.R.

INTER. STATE 5 R/W.  
 S. 21° 10' E. 149.83'

TRACT SURVEYED

N. 89° 51' E. 710.56'

N. 10° 30' W.  
 142.91'

REGISTERED  
 OREGON  
 LAND SURVEYOR

*L. E. Ager*

MARCH 10, 1944  
 L. E. AGER  
 21


2254

Survey narrative to comply with ORS 209.250

For: David L. Curtis, 563 N. Main St. Ashland, Oregon.

Purpose: To mark the boundaries of and describe a tract of land.

Procedure: I used monuments as set previously on the boundaries of tract adjacent to and bounding this tract to the North and I found Interstate 5 R/W monuments which I used for the Westerly boundary control of this tract. the East line of this controlled by S.P.R.R. right of way.

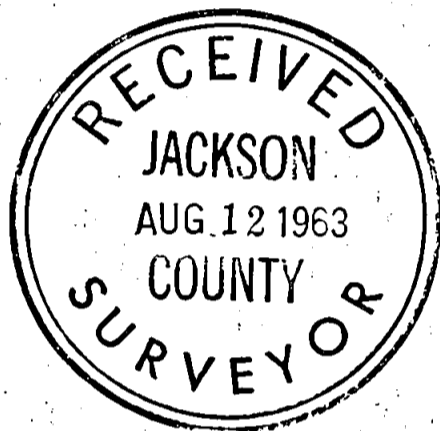

*L. E. Ager*

