

MAP OF SURVEY  
FOR  
LUKE JONES

LOCATED IN:  
LOT 7 & LOT 8, BLOCK 33 OF  
THE ORIGINAL TOWNSITE, CENTRAL POINT,  
IN THE N.W. 1/4 SEC. 11, T.37S., R.2W., W.M.  
CITY OF CENTRAL POINT, JACKSON COUNTY, OREGON

SURVEY NARRATIVE TO COMPLY WITH PARAGRAPH 209.250  
OREGON REVISED STATUTES

PURPOSE: To survey and monument property described in  
Instrument No. 2014-020728 of the Official Records of  
Jackson County, Oregon

PROCEDURE: The property being surveyed is Lot 7 and Lot 8  
of block 33 of the Original Townsite of Central Point. No  
evidence of original monumentation could be found for the  
Block 33 lots. Surveys No. 20143 and 20253 had located street  
centerline monuments, which were recovered for this survey to  
establish the Block 33 boundary. The location of the lots were  
then computed by proration, and monuments were set as  
shown.


Equipment used: Trimble S6 Robotic Instrument.

HOFFBUHR & ASSOCIATES, INC.  
880 GOLF VIEW DRIVE, SUITE 201  
MEDFORD, OREGON 97504  
(541)779-4641

BY: DARRELL L. HUCK PLS No. 2023  
SCALE: 1 Inch = 50 JANUARY 19, 2019  
BASIS OF BEARING: SURVEY NO. 20143



- = Set 5/8"x24" Iron reinforcing pin with plastic cap stamped "D. Huck LS 2023".
- = Found 5/8" Iron pin per S/N 20143
- ⊙ = Found brass cap monument per S/N 20143 & 20253
- △ = Deferred Monument
- (-) = Record per Plat of Central Point
- P/P = Proportion distance
- O.R. = Official Records, Jackson County, Oregon

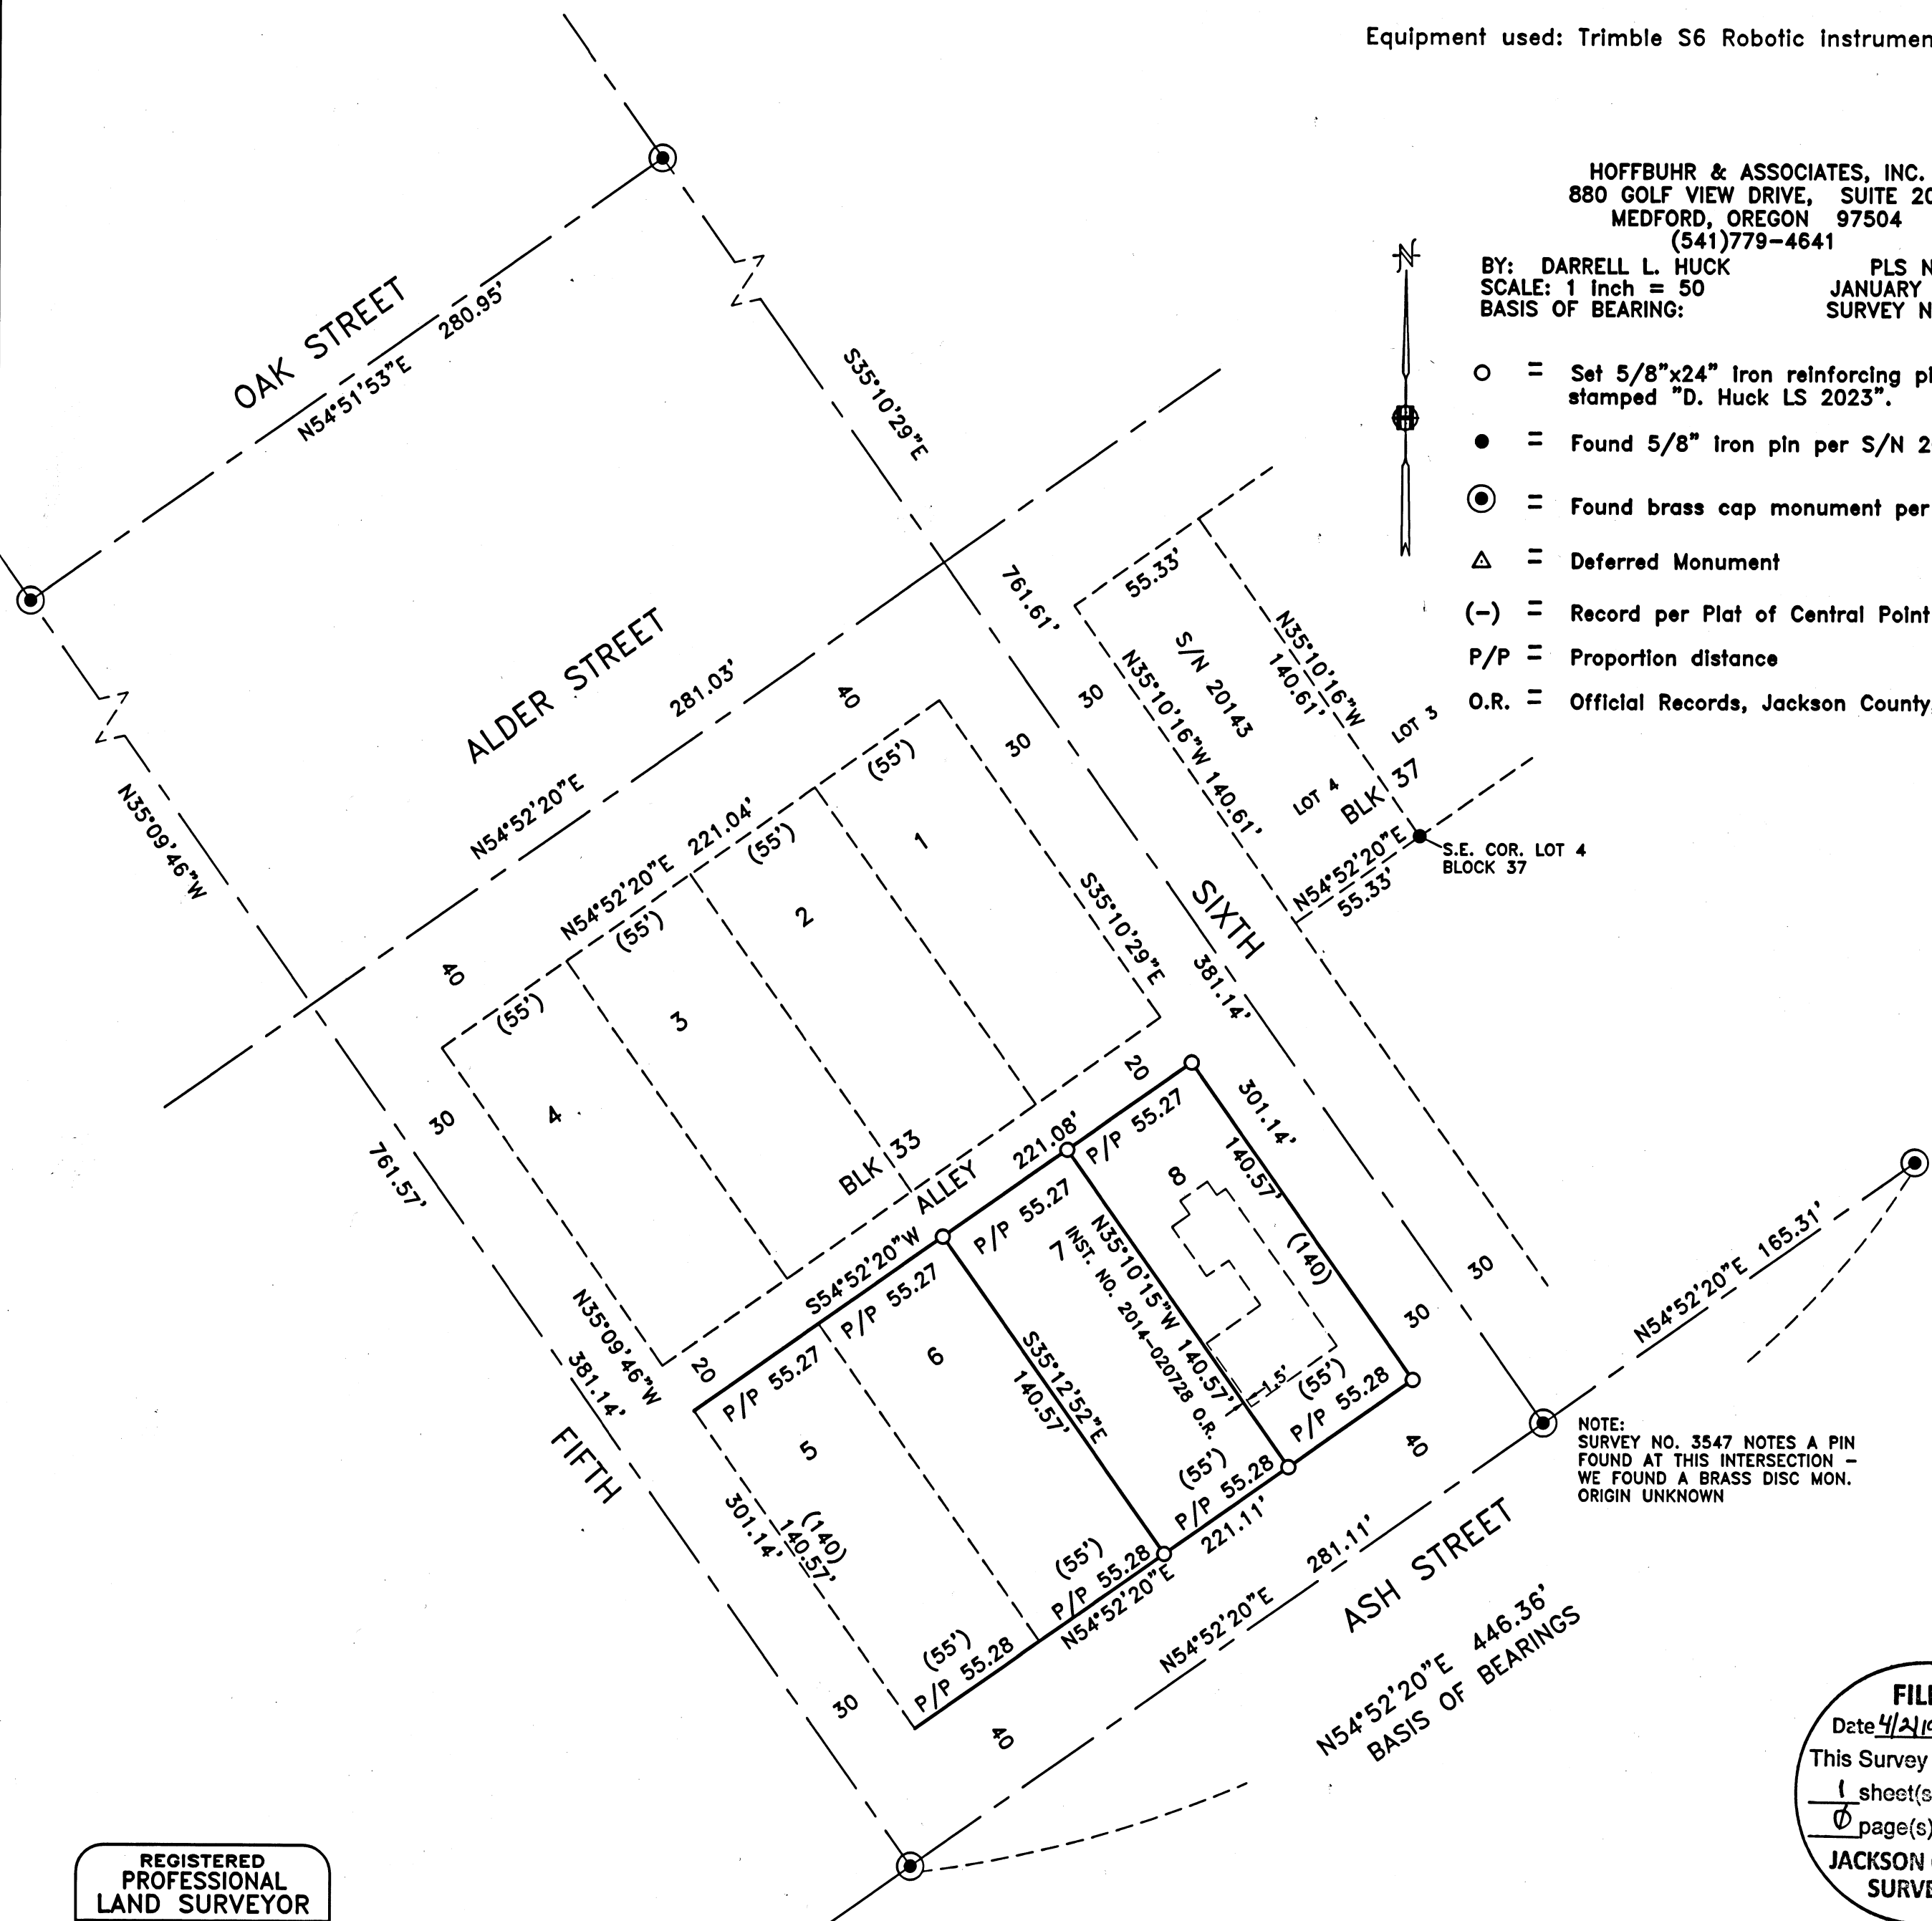

NOTE:  
SURVEY NO. 3547 NOTES A PIN  
FOUND AT THIS INTERSECTION -  
WE FOUND A BRASS DISC MON.  
ORIGIN UNKNOWN

REGISTERED  
PROFESSIONAL  
LAND SURVEYOR  
*Darrell L. Huck*  
OREGON  
FEBRUARY 4, 1983  
DARRELL L. HUCK  
2023  
Expires 6/30/2019

FILED  
Date 4/21/19 By *SHS*  
This Survey Consist Of:  
1 sheet(s) Map  
0 page(s) Narrative  
JACKSON COUNTY  
SURVEYOR