

2281

Survey For
JACKSON COUNTY
Located in Secs. 23 & 24, T.33 S., R.1 E., W.M.
By: Mark E. Boyden
April, 1963

Found 3 Original B.T.'s

14 13
23 24 Set 1" iron pipe / bronze cap
Section corner

1365.17'

1/16 corner

N 0°06'40"W 5460.68'

1365.17'

PP. 1/4 Section corner
Set 1" iron pipe / bronze cap

1365.17'

1/16 corner

1365.17'

23 24 Section corner
26 25 Found 2" iron pipe & B.T.'s

N

SCALE 1" = 1000'

o Set 1" Galvanized Iron pipe

Meridian by Solar Observation


REGISTERED
OREGON
LAND SURVEYOR

Mark E. Boyden
NOVEMBER 9, 1951
MARK E. BOYDEN
281

RECEIVED
JACKSON
SEP 10 1963
COUNTY
SURVEYOR

2281

SURVEY NARRATIVE TO COMPLY WITH O.R.S. 209.250

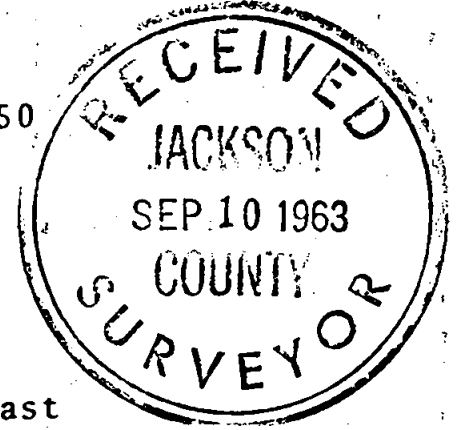

FOR: Jackson County Engineer,
Court House
Medford, Oregon

PURPOSE: To locate, monument and reference, the East Boundary of Section 23, Township 33 South, Range 1 East, Willamette Meridian.

PROCEDURE:

Ran transit-chain traverse between the Southeast and Northeast Corners of Section 23.

The Northeast Corner and East Quarter Corner were monumented, referenced and recorded in the re-establishment volume on file in the office of the County Surveyor.

At the North One-sixteenth Section Corner common to Sections 23 & 24, set a 1" x 36" galvanized iron pipe, 35" in the ground for corner, from which:

A 36" B. Oak, scribed "RS 281-BT" bears North $31\frac{1}{4}^{\circ}$ East, 104.3 feet to the face of the upper blaze;

An 18" B. Oak, scribed "RS 281-BT" bears South $81\frac{3}{4}^{\circ}$ East, 74.9 feet to the face of the upper blaze.


At the South One-sixteenth Section Corner common to Sections 23 & 24, set a 1" x 36" galvanized iron pipe, 28" in the ground for corner, from which:

A 36" Cottonwood, scribed "RS 281-BT" bears South $1\frac{1}{2}^{\circ}$ West, 164.6 feet to the face of the upper blaze;

A 20" Fir, scribed "RS 281-BT" bears South 49° West, 236.2 feet to the face of the upper blaze.

Meridian was determined from a mean of four solar observations.

August 1963

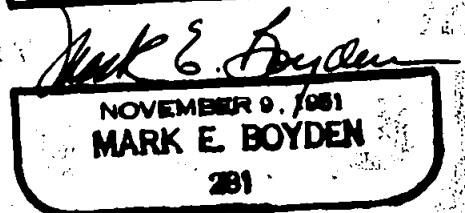

MARK E. BOYDEN
281