


MAP OF SURVEY  
FOR  
BRIAN HEIMANN

LOCATED IN:  
LOTS 1,2,3 & 4, BLOCK 40 IN THE TOWN OF JACKSONVILLE,  
IN THE N.W. 1/4 OF SEC. 32, T.37S., R. 2W., W.M.,  
CITY OF JACKSONVILLE, JACKSON COUNTY, OREGON

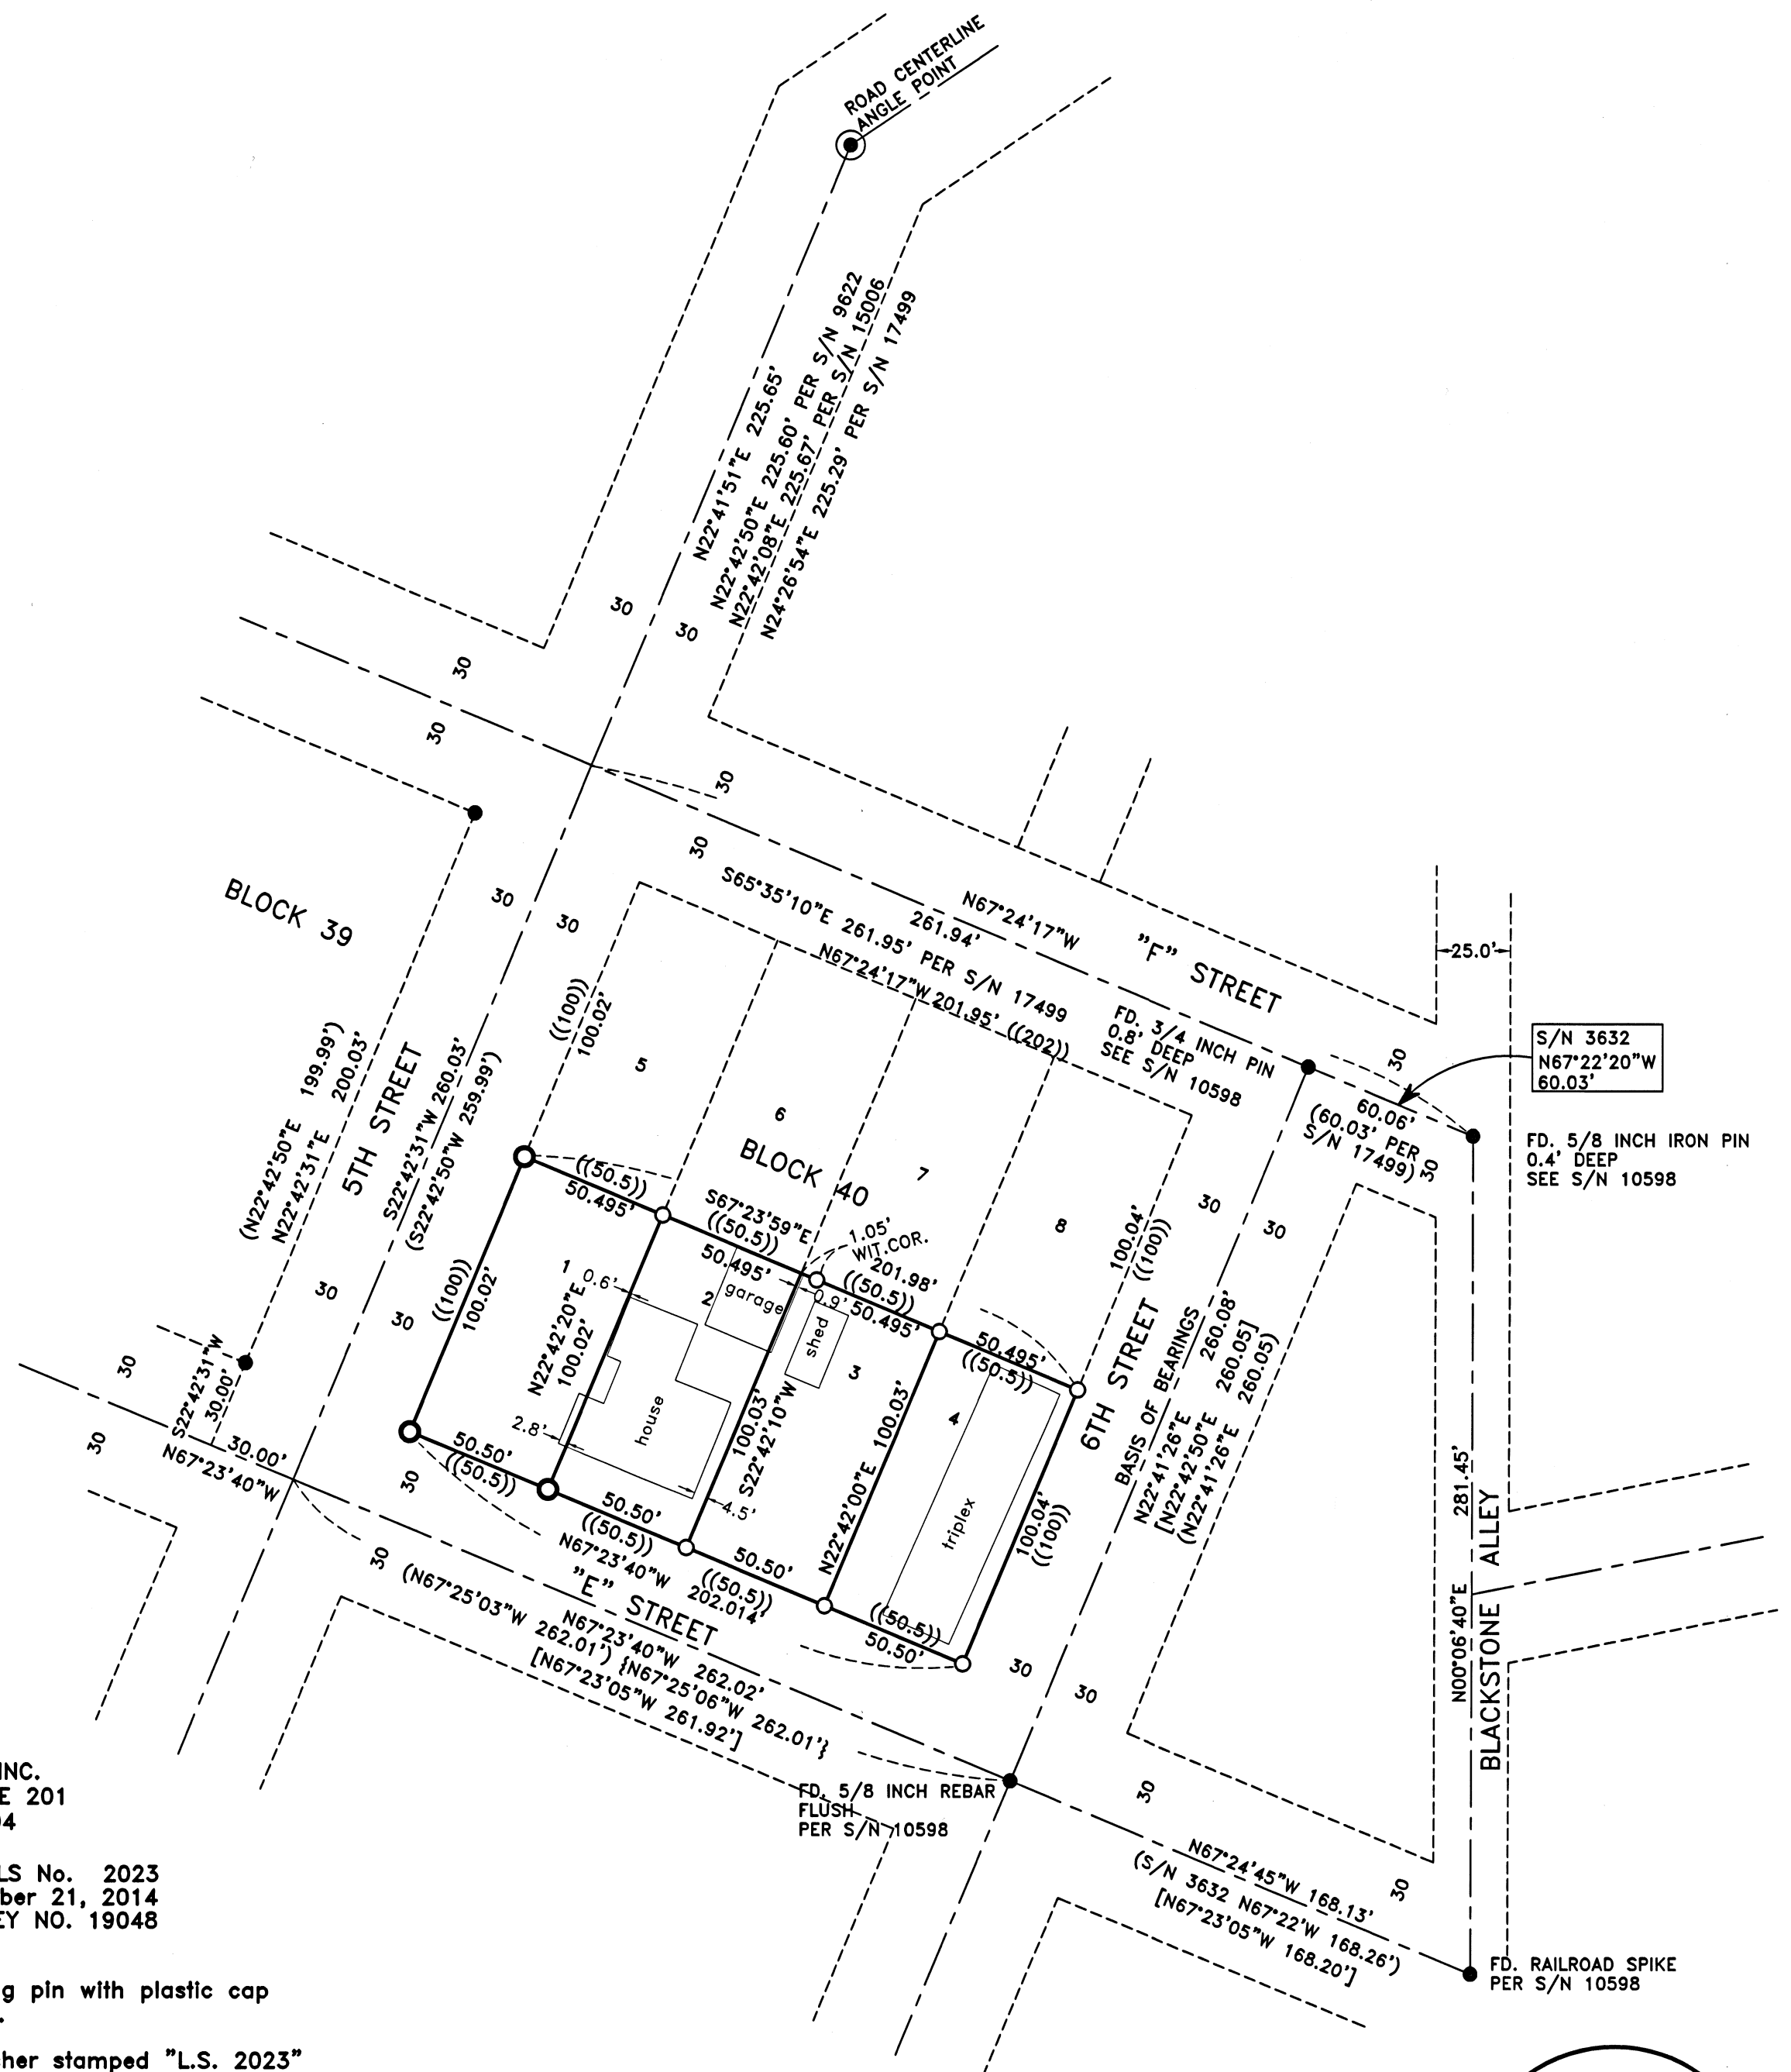

HOFFBUHR & ASSOCIATES, INC.  
880 GOLF VIEW DRIVE, SUITE 201  
MEDFORD, OREGON 97504  
(541)779-4641

BY: DARRELL L. HUCK PLS No. 2023  
SCALE: 1 Inch = 50' November 21, 2014  
BASIS OF BEARING: SURVEY NO. 19048

- = Set 5/8"x24" Iron reinforcing pin with plastic cap stamped "D. Huck LS 2023".
- = Set lead plug w/ brass washer stamped "L.S. 2023"
- = Found lead plug w/ tag marked "2653" per S/N 19048 unless noted otherwise
- ⊙ = Found 1/2 Inch pipe in mon. case per S/N 9622
- S/N = Survey Number
- D.R. = Deed Record per Inst. No. 2014-022937
- O.R. = Official Records, Jackson County, Oregon
- WIT.COR. = Witness Corner
- (-) = Record per Survey No. 19048
- [-] = Record per Survey No. 10598
- {-} = Record per Survey No. 15584
- ((-)) = Record per plat Original Town Of Jacksonville
- \*-x-\* = Fence line

SURVEY NARRATIVE TO COMPLY WITH PARAGRAPH 209.250  
OREGON REVISED STATUTES

PURPOSE: To survey and monument the boundary of that property described in Instrument No. 2018-012990 of the Official Records of Jackson County, Oregon

PROCEDURE: A control traverse was run tying monuments found per filed Surveys No. 9622, 12662, 10598 and 19048. Monuments per surveys no. 9622 and 19048 were held to control the location of 5th Street. Monuments found per surveys no. 10598 and 19048 were held to control the location of "F" Street and the location of "E" Street was determined from monuments per survey no. 10598 and 19048. Utilizing the computed street alignments, the Block 40 boundary was computed and the location of the Lot lines was calculated by proration, which was in close agreement with plat record dimensions.

Equipment used: Trimble S6 Robotic Instrument.

**\*\*RECEIVED\*\***  
Date 5/13/19 By PH  
This survey consists of:  
1 sheet(s) Map  
2 pages(s) Narrative  
JACKSON COUNTY  
SURVEYOR

REGISTERED  
PROFESSIONAL  
LAND SURVEYOR

*Darrell L. Huck*  
OREGON  
FEBRUARY 4, 1983  
DARRELL L. HUCK  
2023

Expires 6/30/2019  
(19043 MOS R1.DWG)