


2283

Survey For  
Plummer Enterprises Inc.  
Located in Sec. 15, T36SR3W, W.M.  
Gold Hill, Oregon  
By: Mark E. Boyden  
July, 1963

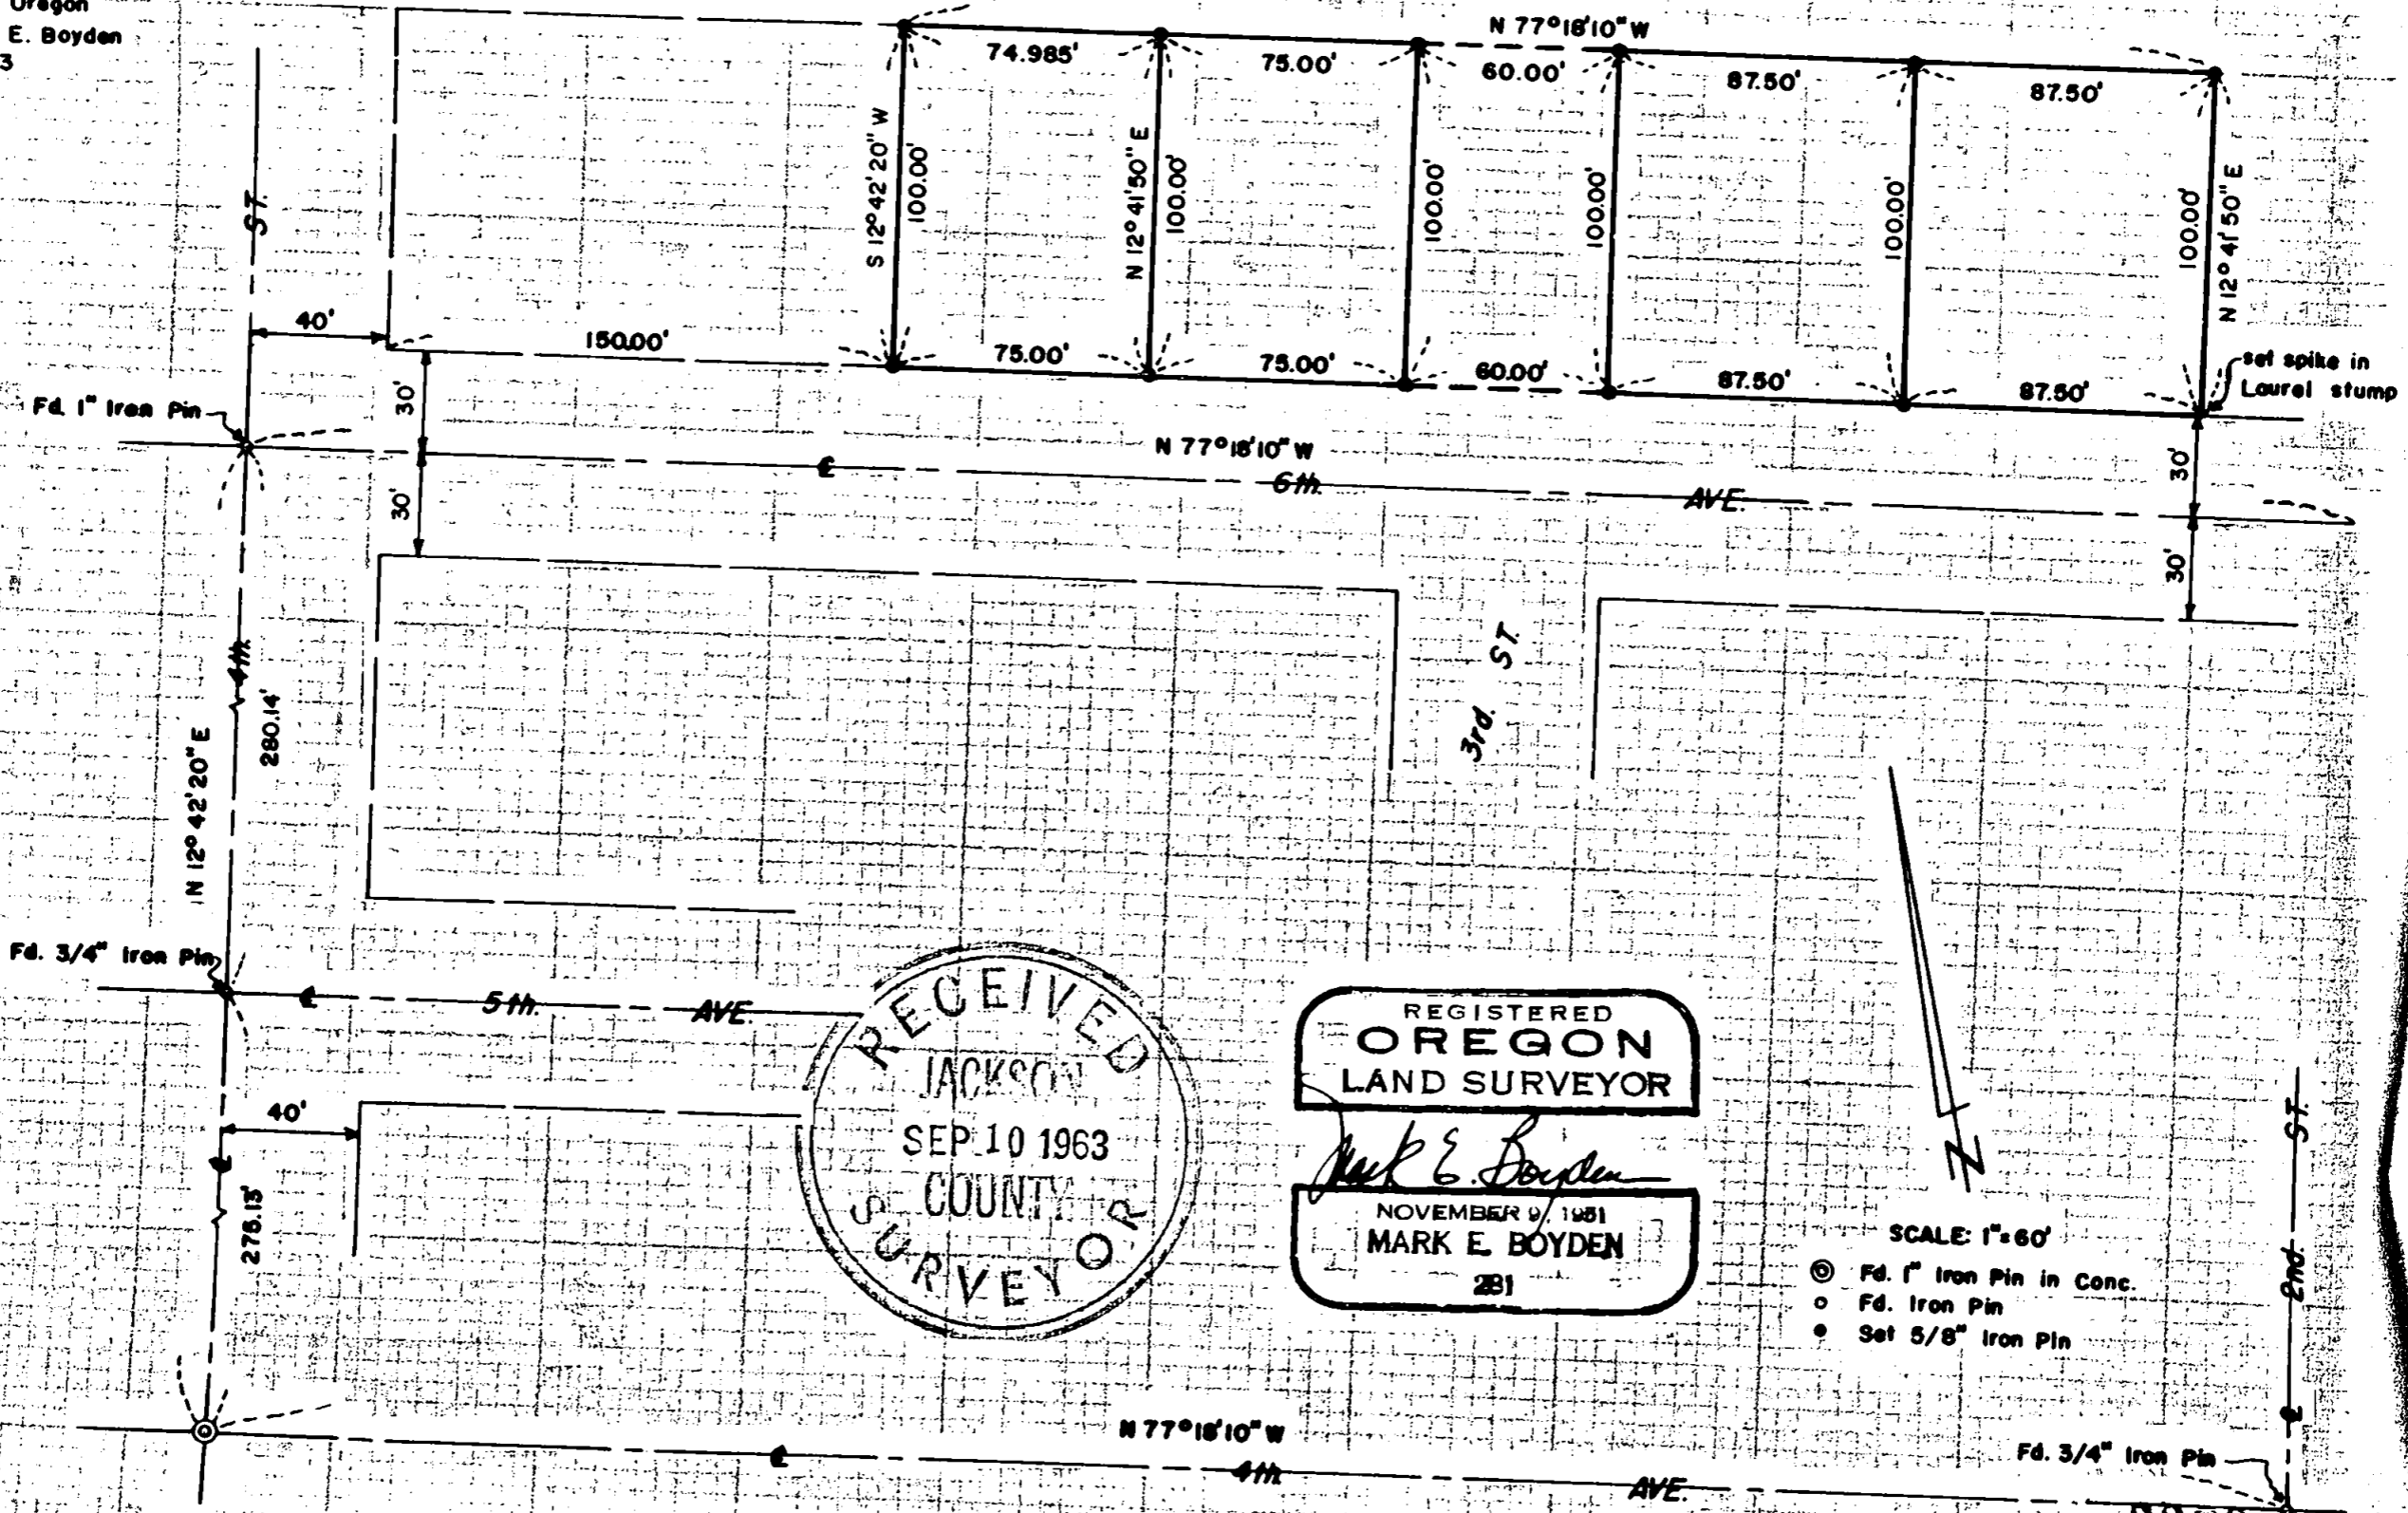

RECEIVED  
JACKSON  
SEP 10 1963  
SURVEYOR

REGISTERED  
OREGON  
LAND SURVEYOR  
*Mark E. Boyden*  
NOVEMBER 9, 1961  
MARK E. BOYDEN  
281

SCALE: 1" = 60'  
 ⊙ Fd. 1" Iron Pin in Conc.  
 ○ Fd. Iron Pin  
 ● Set 5/8" Iron Pin

2283

Survey No. 2283

SURVEY NARRATIVE TO COMPLY WITH O.R.S. 209.250

FOR: Plummer Enterprises, Inc.  
520 Second Avenue  
Gold Hill, Oregon

LOCATION: Southeast 1/4 of the Southwest 1/4, Section 15,  
Township 36 South, Range 3 West, Gold Hill, Oregon.

PURPOSE: To monument those parcels described in Volume 547,  
Pages 78-81 of the Deed Records of Jackson County,  
Oregon.

PROCEDURE:

Found previously established street center monuments  
as shown.

In that no monuments could be found on Sixth Avenue  
Easterly from Fourth Street, the centerline of Sixth Avenue  
was established parallel to monumented Fourth Avenue.

The Most-Westerly parcel was monumented so that the  
previous deeded property to the West (See Volume 344,  
Page 44, Deed Records) would develop a full 150.00 feet in the  
East-West dimension.

The remaining lots were monumented deed distance  
Easterly from Fourth Street and at right angles to Sixth  
Avenue.

August 1963

