


REGISTERED
OREGON
 LAND SURVEYOR

C. Lind McBeth

JANUARY 12, 1962
 C. LIND MCBETH
 565

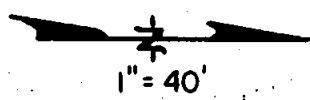

BOUNDARY SURVEY IN
 N.W. 1/4 N.E. 1/4 S.E. 1/4 SEC. 31 T. 37 S. R. 2 W. W.M.

FOR:

MR. RICHARD D. ELBERT

8/7/63

BY C. LIND MCBETH L.S.
 JACKSONVILLE, OREGON

63-4

RECEIVED
 JACKSON
 SEP 16 1963
 COUNTY
 SURVEYOR

August 31 1963

Survey Narrative to comply with O.R.S. 209-250

Survey For : Mr. Richard D. Elbert
S. Oregon Ave.
Jacksonville, Oreg.

Purpose Of Survey: To establish boundary lines of an
M. & B. lot.

Basis of Bearing : Previous Survey

Survey Proceedure: Found a 1½" iron pipe being the center
E. 1/16 cor. of Sec.31, T37S, R2W., W. M.
Then sighted East along the E-W center-
line of said Section and set a 3/4 "
Iron Pin for the N.E. Cor. of this
Property; thus having a control line
I surveyed the parcel as shown on the
accompanying plat as requested by the
Client.

63-4



C. Lind McBeth

