


CORNER OF SECTIONS 5, 6, 7, & 8:
FOUND 1" I.D. G.I.P. WITH 2 1/2" DIAMETER
BRASS CAP STAMPED "T.39S. R.1W. 5 6 7 8
SEC. COR. C.S. 1969", 4" ABOVE GROUND,
FROM WHICH BEARS:

41" DF STUMP S47°W 19.1' F (19.4' R3).
24" DF ROTTED STUMP N62°W 12.7' F=R3.
24" DF ROTTED STUMP S11°E 4.8' F=R3.
24" DF ROTTED STUMP N65 1/2°E 19.2' F=R3.
1/2" I.D. IRON PIPE, NO IDENTIFICATION,
N48°E 0.8' F=R6.

S6 S5
S7 S8
N89°33'27"W 1290.46' F
(N89°36'02"W 1290.63' R4)

WEST 1/16 CORNER OF SECTIONS 5 & 8:
FOUND 1" I.D. G.I.P. WITH 2 1/2" DIAMETER
BRASS CAP STAMPED "SWAIN SURVEYING T.39S.
R.1W. W 1/16 S5 S8 COR. PLS 759 1974",
4" ABOVE GROUND, AND BEARING TREES PER R4:

16" DF WITH HB S82 3/4°E 26.1' F
(RED FIR, 25.6 R4).
20" DF STUMP WITH HB S52 1/4°W 19.5'
(RED FIR R4).

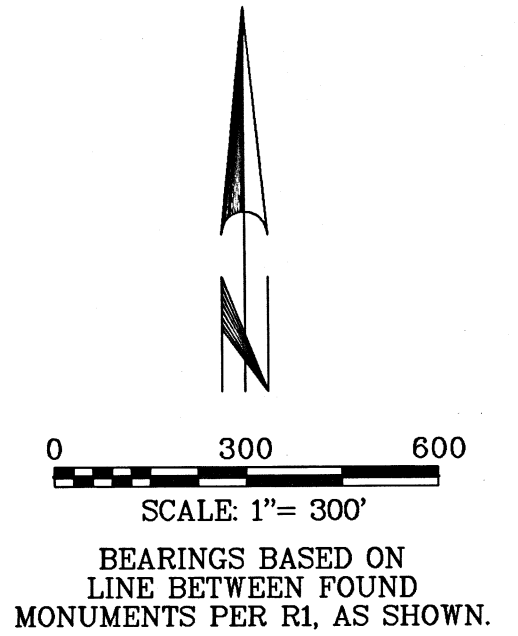

T.L. 4600
ANDERSON
D.N. 2015-026478
T.L. 4700

N 1/16 CORNER OF SECTION 8:
SET 5/8" DIAMETER REBAR, 30" LONG,
26" IN THE GROUND WITH A 2 1/2"
ALUMINUM CAP STAMPED "T39S RIW N1/16
S7 S8 2019 PLS 77662", FROM WHICH BEARS:

7" IC SCRIBED "XBT" N62°W 45.3'.
6" MAD SCRIBED "XBT" N23°E 15.3'.
3/4" IRON PIPE, NO IDENTIFICATION,
S50°38'W 3.5'.

NW 1/16 CORNER OF SECTION 8:
SET 5/8" DIAMETER REBAR, 30" LONG,
26" IN THE GROUND WITH A 2 1/2"
ALUMINUM CAP STAMPED "T39S RIW NW1/16
S8 2019 PLS 77662", FROM WHICH BEARS:

8" MADRONE SCRIBED "XBT" S51°W 14.2'.
8" DF SCRIBED "XBT" N64°E 13.7'.

SISKIYOU
TIMBERLANDS, LLC
D.N. 2019-007511
T.L. 4800

U.S.A.
T.L. 2000

1/4 CORNER OF SECTIONS 7 & 8:
FOUND 1" I.D. G.I.P. WITH 3" DIAMETER
BRASS CAP STAMPED "T39S RIW 1/4 S 7 8
CS 1987", 6" ABOVE GROUND, AND BEARING
TREES PER R1:

20" MAD WITH ROTTED BLAZE S85°E 12.8'
(13.9' R1).
10" MAD WITH HB S42°W 11.9' F=R1.
35" DF WITH HB N27°W 42.2' F=R1.
10" DF WITH HB S50 1/4°E 30.4' F=R1.

T.L. 4800

SISKIYOU
TIMBERLANDS, LLC
D.N. 2019-007511
T.L. 4800

C-N 1/16 CORNER OF SECTION 8:
FOUND BLM 2 1/2" O.D. STAINLESS STEEL
POST WITH 3 1/4" DIAMETER BRASS CAP
STAMPED "N 1/16 C-C S8 1990", 6" ABOVE
GROUND, WITH BEARING TREES PER R1:

21" YP WITH HB S39 3/4°E 6.4' F
(S45 1/4°E 5.9' R1).
18" DF WITH HB S53 1/4°W 19.8' F=R1.

N1°30'52"W 1366.46' F
(N1°33'30"W 1367.19' R1)

1322.01'
BASIS OF BEARINGS: N86°45'00"W 2644.02' F (N86°45'00"W 2644.29' R1)

C1/4 CORNER OF SECTION 8:
FOUND BLM 2 1/2" O.D. STAINLESS STEEL
POST WITH 3 1/4" DIAMETER BRASS CAP
STAMPED "T39S RIW C1/4 S8 1990",
18" ABOVE GROUND, LOOSELY SET, PER R1.
SOLIDIFIED MONUMENT WITH A MOUND OF
STONE, 2 1/2" DIAM, 12" HIGH, FROM
WHICH THE BEARING TREES PER R1:

10" DF WITH HB N79 1/4°E 17.2' F=R1.
8" DF WITH HB S30 1/4°W 16.5' F=R1.

S7 S8
SISKIYOU
TIMBERLANDS, LLC
D.N. 2019-007511
T.L. 5000

LEGEND OF SYMBOLS & ABBREVIATIONS

- FOUND BLM MONUMENT AS NOTED.
- ⊗ FOUND MONUMENT AS NOTED.
- ⊙ SET MONUMENT AS NOTED.
- BLM BUREAU OF LAND MANAGEMENT
- CS COUNTY SURVEY
- DF DOUGLAS FIR
- D.N. DOCUMENT NUMBER
- F FIELD MEASUREMENT
- G.I.P. GALVANIZED IRON PIPE
- GLO GENERAL LAND OFFICE
- HB HEALED BLAZE
- IC INCENSE CEDAR
- I.D. INSIDE DIAMETER
- MAD MADRONE
- O.D. OUTSIDE DIAMETER
- T.L. TAX LOT
- YP YELLOW PINE
- () INDICATES RECORD DATA

U.S.A.
T.L. 4400

REFERENCES:

- R1 = PLAT AND NOTES FOR BLM DEPENDENT RESURVEY BY NICKERSON & HARTLEY, APPROVED AUG. 11, 1993.
- R2 = NOTES FOR BLM DEPENDENT RESURVEY BY SIMON, APPROVED DECEMBER 18, 2009.
- R3 = CS CORNER RECORD 9/27/1995
- R4 = CS 5814
- R5 = GLO PLAT FOR T.39S., R.1W., APPROVED APRIL 10, 1884.
- R6 = CS CORNER RECORD 5/29/1969

SURVEY NARRATIVE:

THE PURPOSE OF THIS SURVEY IS TO MONUMENT, FLAG, BLAZE, AND PAINT THE LINES ALONG THE BOUNDARIES OF THE PARCEL DESCRIBED IN D.N. 2019-007511 (COMMONLY KNOWN AS TAX LOTS 4800 AND 5000), SHOWN AS BOLD LINES HEREON.

USING FOUND MONUMENTS AS SHOWN, I RETRACED THE WESTERLY LINE OF SECTION 8 AND SUBDIVIDED THE NORTHWEST QUARTER OF SECTION 8 PER THE BLM MANUAL OF SURVEY INSTRUCTIONS, 2009.

ALL BEARINGS AND DISTANCES SHOWN TO BEARING TREES ARE FROM THE CORNER TO THE CENTER OF THE TREE AT GROUND LEVEL.


THIS SURVEY WAS CONDUCTED USING A TOPCON GTS 3003W TOTAL STATION AND TOPCON HIPER AND GR3 STATIC GPS RECEIVERS. THE FIELD SURVEY COMMENCED JUNE 19, 2019 AND WAS COMPLETED JUNE 28, 2019.

CORNER OF SECTIONS 7, 8, 17, & 18:
FOUND 1" I.D. G.I.P. WITH 2 1/2" DIAMETER
BRASS CAP STAMPED "T.39S. R.1W. 7 8 17 18
SEC. COR. C.S. 1970", 6" ABOVE GROUND,
AND BEARING TREES PER R2:

11" MAPLE WITH ROTTED BLAZE N40°E 18.1' F=R2.
12" MAPLE WITH ROTTED BLAZE S67°E 15.9' F
(S70°E 16.5' R2).
50" DF STUMP, ROTTED, S45°W 4.9' F (4.0' R2).
49" DF WITH HB N62°W 19.1' F=R1.
22" DF WITH HB N63°E 38.5' F=R1.
19" DF WITH HB S49 1/2°E 63.4' F=R1.

S7 S8

S18 S17

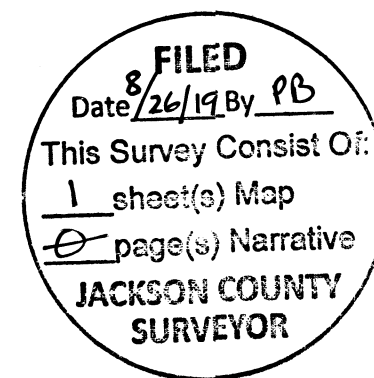

REGISTERED
PROFESSIONAL
LAND SURVEYOR

Gregg Arnold Neitsch

OREGON
JULY 11, 2006
GREGG ARNOLD NEITSCH
77662LS
EXPIRES: 12/31/2020

MAP OF SURVEY

FOR
SISKIYOU
TIMBERLANDS, LLC

THE NORTHWEST 1/4 AND THE
WESTERLY LINE OF SECTION 8,
T. 39 S., R. 1 W., W.M.,
JACKSON COUNTY, OREGON

NORTH STATE LAND SURVEYING
1511 KYLYNN CT.
MOUNT SHASTA, CA

JULY 2019 SCALE: 1"=300' SHEET 1 OF 1
ANDERGN.D.ASC ANDER.MOS.GXD JOB NO. 585