



T.32S., R.4W.
S35

CC CORNER OF SECTIONS 2 & 3:

FOUND BLM 2 1/2" O.D. GIP, PROJECTING 4"
ABOVE GROUND, WITH A 3 1/4" DIAM. BC STAMPED
"T32S R4W S35 S3 S2 CC T33S 1975", PER R2,
FROM WHICH BEARS:

20" DF WITH HB S85°W 34.3' F (S87°W R2).
26" IC WITH HB S13 1/2°E 44.1' F
(S11 1/2°E 45.5' R2).

MURPHY TIMBER
INVESTMENTS, LLC
D.N. 2015-003777
T.L. 300

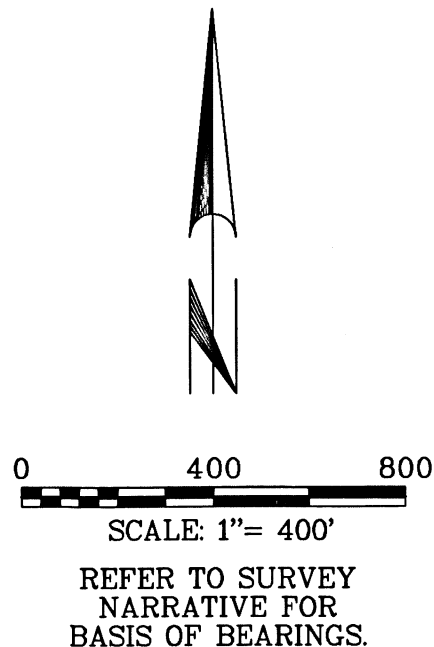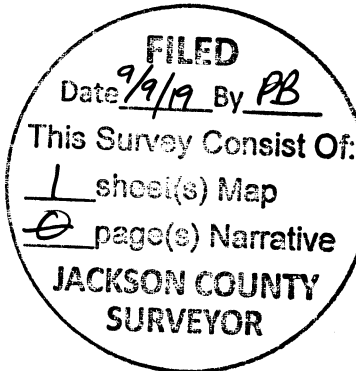

SURVEY NARRATIVE:

THE PURPOSE OF THIS SURVEY IS TO BLAZE THE LINES
OF TAX LOTS 200 AND 300 WITH TAX LOTS 400 AND 1600,
AS SHOWN IN BOLD HEREON.

USING FOUND BLM MONUMENTS AS SHOWN, I RETRACED THE
LINES BETWEEN SECTIONS 2 & 3, AND 2 & 11, AS
DESCRIBED IN DEED FOR TAX LOTS 200 AND 300
(D.N. 2015-003777).

THIS SURVEY WAS CONDUCTED USING A TOPCON GTS 3003W TOTAL
STATION AND TOPCON HIPER AND GR3 STATIC GPS RECEIVERS.
THE FIELD SURVEY COMMENCED JULY 17, 2019 AND WAS
COMPLETED JULY 25, 2019.

THE BASIS OF BEARINGS FOR THIS SURVEY IS GEODETIC (NAD83),
AT THE CORNER OF SECTIONS 2, 3, 10, & 11 SHOWN HEREON,
BASED ON STATIC GPS OBSERVATIONS TO CONTINUOUSLY OPERATING
REFERENCE STATIONS (EPOCH 2010.00).

ALL FIELD BEARING AND DISTANCES TO BEARING TREES ARE TO
THE CENTER OF THE TREE AT THE GROUND.

LEGEND OF SYMBOLS & ABBREVIATIONS

- FOUND MONUMENT AS NOTED.
- BC BRASS CAP
- BLM BUREAU OF LAND MANAGEMENT
- DF DOUGLAS FIR
- F FIELD MEASUREMENT
- GIP GALVANIZED IRON PIPE
- GLO GENERAL LAND OFFICE
- I.C. INCENSE CEDAR
- O.D. OUTSIDE DIAMETER
- WF WHITE FIR
- () INDICATES RECORD DATA

REFERENCES:

- R1 = GLO PLAT OF T.33S., R.4W.,
W.M., APPROVED JULY 26, 1894.
- R2 = BLM PLAT & NOTES FOR 1975
ROSEBERRY & AANRUD SURVEY
ACCEPTED MAY 21, 1982.
- R3 = BLM 1962 REMONUMENTATION
NOTES BY JAMES E. JELLEY.
- R4 = CS 18425

U.S.A.
T.L. 400

1/4 CORNER OF SECTIONS 2 & 3:

FOUND BLM 2 1/2" O.D. GIP, PROJECTING 8"
ABOVE GROUND, WITH A 3 1/4" DIAM. BC STAMPED
"T33S R4W 1/4 S3 S2 1975", PER R2, FROM WHICH
BEARS:

24" DF WITH HB S74°E 45.4' F (S70 3/4°E 46.5' R2).
12" IC SCRIBED "XBT" THIS SURVEY S39°W 11.6'.

CORNER OF SECTIONS 2, 3, 10, & 11:

FOUND BLM 2 1/2" O.D. GIP, PROJECTING 8"
ABOVE GROUND, WITH A 3 1/4" DIAM. BC STAMPED
"T33S R4W S2 S3 S10 S11 1962", PER R3,
FROM WHICH BEARS:

60" DF WITH HB S80°E 17.2' F=R2.
42" DF STUMP WITH HB S65°W 56.8' F
(56.1' R2).
9" DF WITH HB S25°W 25.1' F=R4.

MURPHY TIMBER
INVESTMENTS, LLC
D.N. 2015-003777
T.L. 200

CORNER OF SECTIONS 1, 2, 11, & 12:

FOUND BLM 2 1/2" O.D. GIP, PROJECTING 6"
ABOVE GROUND, WITH A 3 1/4" DIAM. BC STAMPED
"T33S R4W S1 S2 S11 S12 1962", PER R3,
FROM WHICH BEARS:

28" MADRONE WITH ROTTED BLAZE N69°E 10.6' F = R3.
30" WF WITH HB S38°E 25.7' F = R3.

REGISTERED
PROFESSIONAL
LAND SURVEYOR

OREGON
JULY 11, 2006
GREGG ARNOLD NEITSCH
77662LS

EXPIRES: 12/31/2020

MAP OF SURVEY

FOR
MURPHY TIMBER INVESTMENTS, LLC

THE LINE BETWEEN SECTIONS 2 & 3,
AND BETWEEN SECTIONS 2 & 11,
T. 33 S., R. 4 W., W.M.,
JACKSON COUNTY, OREGON

NORTH STATE LAND SURVEYING
1511 KYLYNN CT.
MOUNT SHASTA, CA

AUGUST 2019 SCALE: 1"=400' SHEET 1 OF 1
GRAVEGND.ASC GRAVE MOS.GXD JOB NO. 590