


MAP OF SURVEY

LOCATED IN THE NORTHWEST 1/4 OF SECTION 30
TOWNSHIP 37 SOUTH, RANGE 1 WEST, WILLAMETTE MERIDIAN,
IN THE CITY OF MEDFORD, JACKSON COUNTY, OREGON

**** RECEIVED ****
DATE 12/11/19 BY SP
This survey consists of:
1 sheet(s) Map
0 page(s) Narrative
JACKSON COUNTY
SURVEYOR

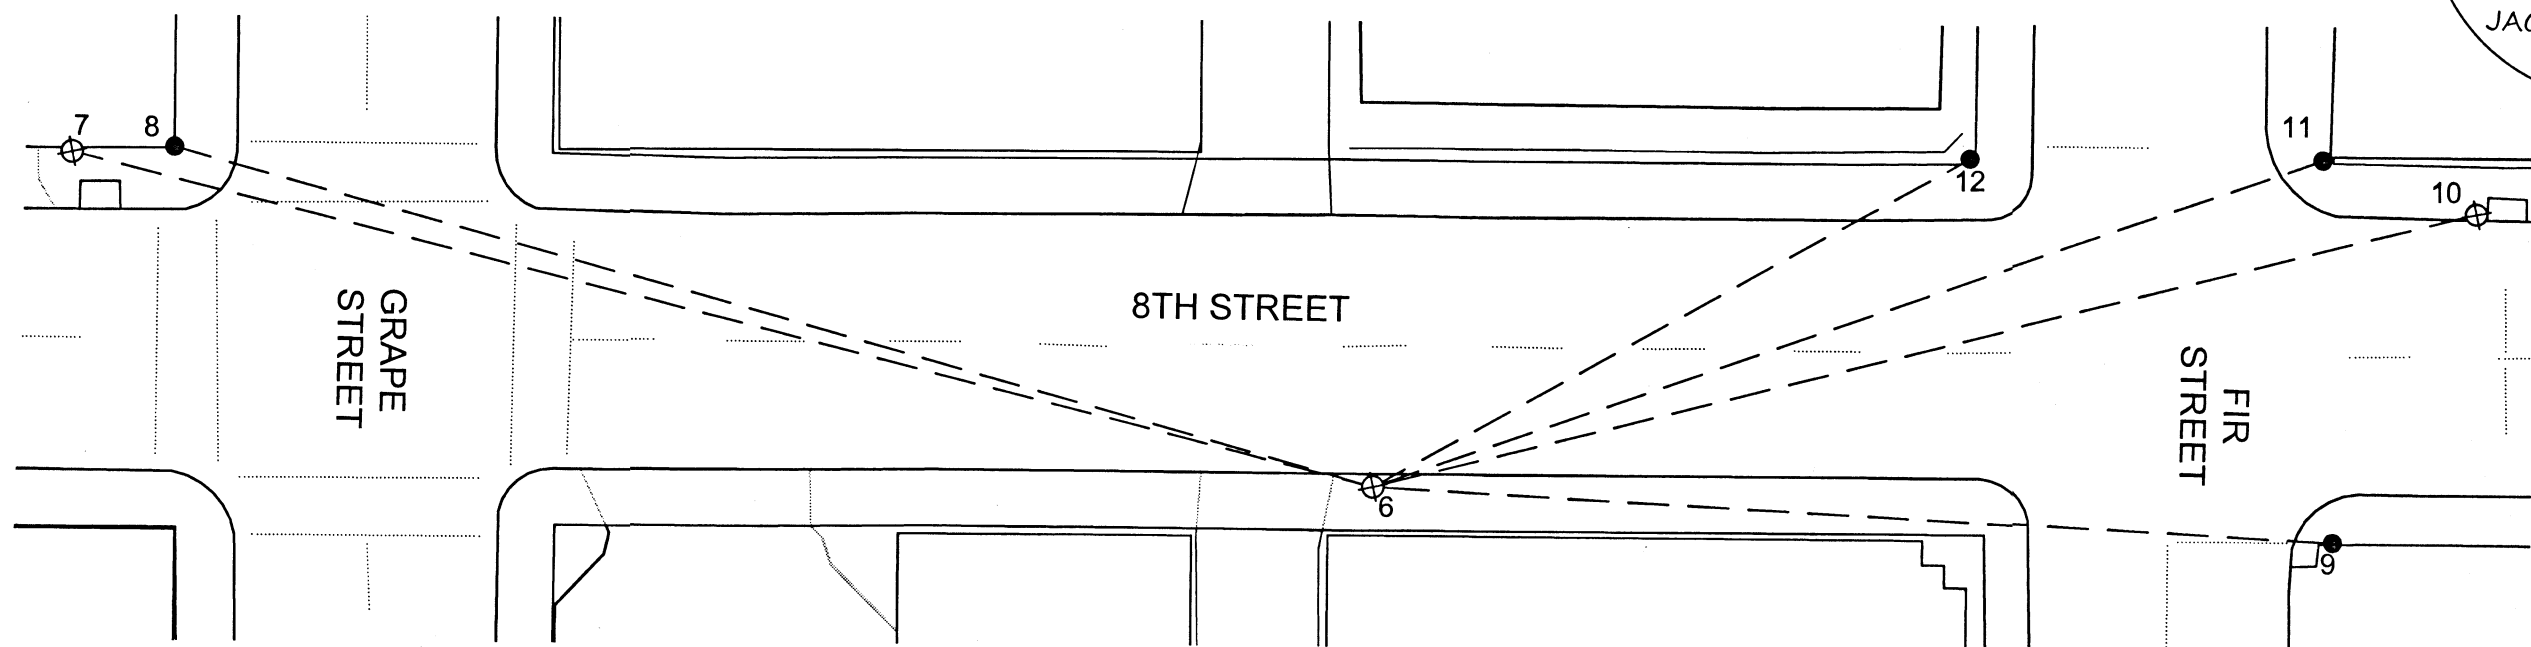

SET UP @ PNT 6 SET .45 SHELL CASING IN SIDEWALK
BACKSIGHT @ PNT 7 SET .45 SHELL CASING IN SIDEWALK

PNT	ANGLE RIGHT	HORIZONTAL DISTANCE	MONUMENT DESCRIPTION	RE-SET MONUMENT DESCRIPTION
7	00-00-00	209.79	SET .45 SHELL CASING IN SIDEWALK	
8	01-23-46	194.54	FD TACK AND WASHER "LS 1069" PER SN 17862	RESET 1" COPPER PLUG MARKED "CITY OF MEDFORD"
12	136-26-02	106.59	FD BRONZE DISK IN SIDEWALK PER SN 20806	RESET 1" COPPER PLUG MARKED "CITY OF MEDFORD"
11	146-21-39	156.99	FD COPPER DISK IN SIDEWALK PER SN 21604	NOT LOST DURING CONSTRUCTION
10	151-28-31	177.58	SET .45 SHELL CASING IN SIDEWALK	
9	168-45-13	150.08	FD LEAD PLUG/TACK PER SN 2033	RESET LEAD & TACK WITH BRASS WASHER MARKED "COM"

LEGEND

- FOUND MONUMENT AS NOTED AND RESET AS NOTED
- ⊗ SET .45 SHELL CASING IN SIDEWALK OR CURB

SURVEY NARRATIVE TO COMPLY WITH O.R.S 209.250

SURVEY FOR/BY: CITY OF MEDFORD, 411 WEST 8TH STREET, MEDFORD, OREGON 97501
DATE OF SURVEY: MONUMENTS MEASURED IN JANUARY 2019, MONUMENTS RESET OCTOBER 2019
PURPOSE: IN ACCORDANCE WITH ORS 209.150, THE PURPOSE OF THIS SURVEY IS TO PERPETUATE EXISTING MONUMENTATION FROM FILED SURVEYS OF RECORD ALONG 8TH STREET FROM THE INTERSECTIONS OF 8TH STREET AND GRAPE STREET TO 8TH STREET AND FIR STREET PRIOR TO CONCRETE ADA RAMP RECONSTRUCTION AND ROAD ASPHALT OVERLAYS.
PROCEDURE: UTILIZING A TRIMBLE S-6 ROBOTIC TOTAL STATION .45 SHELL CASINGS WERE SET AS SHOWN HEREON AS CONTROL FOR THIS SURVEY. FROM SAID CONTROL, REDUNDANT MEASUREMENTS WERE MADE AS SHOWN TO FOUND MONUMENTS.

UPON COMPLETION OF INTERSECTION RECONSTRUCTION, MONUMENTS WERE RE-SET AS SHOWN, FLUSH IN NEW CONCRETE, MARKED "CITY OF MEDFORD".

371W30B AND 372W25AD

REGISTERED
PROFESSIONAL
LAND SURVEYOR
[Signature] 12/11/19
OREGON
JANUARY 9, 2007
JON M. PROUD
77652
EXPIRES DECEMBER 2020

CITY OF MEDFORD - SURVEYING DEPARTMENT	
INTERSECTIONS OF EIGHTH STREET AND GRAPE STREET EIGHTH STREET AND FIR STREET	
DRAWN BY: ZPE	DATE: 10-29-19
CHECKED BY: SPM	DATE: 10-29-19
DATE REFERENCED: 1-28-19	
CREW: ZPE, SPM	SHEET NO. 1 OF 1