22990

RECORD OF MONUMENT PRESERVATION

LOCATED IN THE NORTHEAST 1/4 OF SECTION 3

TOWNSHIP 37 SOUTH, RANGE 2 WEST,

WILLAMETTE MERIDIAN, JACKSON COUNTY, OREGON

** RECEIVED **
DATE 1/10/2020 BY PB
This survey consists of:
1 sheet(s) Map
0 page(s) Narrative
JACKSON COUNTY SURVEYOR

SURVEY NARRATIVE TO COMPLY WITH O.R.S 209.150

DATE OF FIELD SURVEY: MONUMENT RE-SET DECEMBER 14, 2019

BASIS OF BEARING: NONE

PURPOSE: TO RE-SET A DESTROYED CENTERLINE MONUMENTATION ON CREST DRIVE IN CENTRAL POINT AS SHOWN ON FILED SURVEY NUMBER 4830 AND 22988, FOLLOWING SEWER LATERAL CONSTRUCTION.

PROCEDURE: FROM PREVIOUS CORNER RECORD FILED AS SURVEY NUMBER 22988, POINTS 1-4 WERE USED TO RESET POINT 5 AS SHOWN HERE ON.

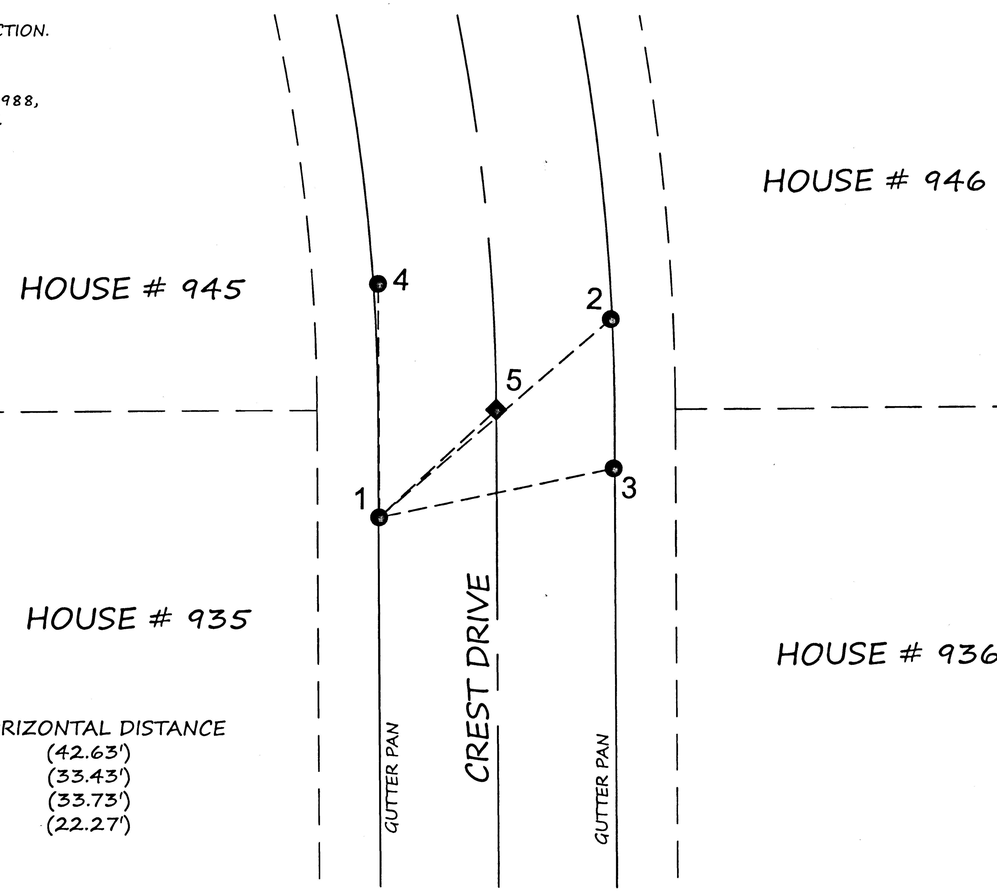

LEGEND

● FOUND MAG NAIL WITH 1-1/2" STEEL WASHER MARKED "MLS 82769"

◆ SET 5/8" REBAR WITH ALUMINUM CAP MARKED "MLS 82769"

(`) RECORD AND MEASURED DATA ARE EQUAL

INSTRUMENT @ POINT 1
BACKSIGHT @ POINT 2

FORESIGHT POINT	ANGLE RIGHT	HORIZONTAL DISTANCE
2	(00-00-00)	(42.63')
3	(28-48-42)	(33.43')
4	(310-26-24)	(33.73')
5	(357-51-49)	(22.27')

REGISTERED
PROFESSIONAL
LAND SURVEYOR

OREGON
JUNE 8, 2009
SEAN P. METZGER
No. 82769
RENEWS: 12/31/2020

PREPARED BY:
METZGER LAND SURVEYING, LLC
P.O. BOX 3521
CENTRAL POINT, OR 97502
PHONE: 541-727-2749

SURVEY FOR:
ROGUE VALLEY SEWER
138 WEST VILAS ROAD,
CENTRAL POINT, OREGON

0' 20'
SCALE: 1"=20'

DRAWN BY: SPM
DATE: 1/08/2020

SHEET 1 OF 1

T37SR2W03A

22990