23017

RECORD OF MONUMENT PRESERVATION

LOCATED IN THE SOUTHWEST 1/4 OF SECTION 8, TOWNSHIP 37 SOUTH, RANGE 1 WEST, WILLAMETTE MERIDIAN, IN THE CITY OF MEDFORD, JACKSON COUNTY, OREGON

** RECEIVED **
DATE 8/21/20 BY PB
This survey consists of:
1 sheet(s) Map
0 page(s) Narrative
JACKSON COUNTY SURVEYOR

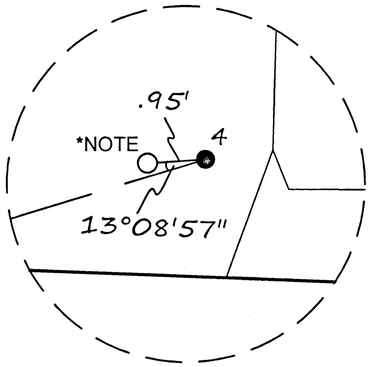

DETAIL "A"

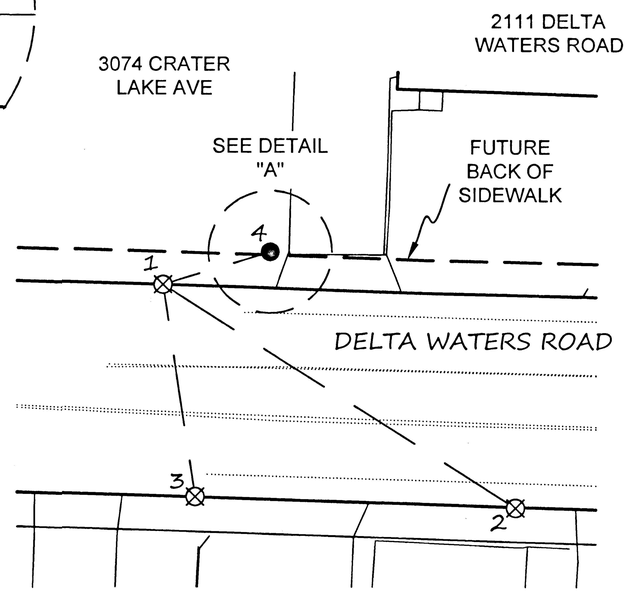

*NOTE- FD 3/4" REBAR WILL NOT BE RESET IF DESTROYED BY CONSTRUCTION

SET UP @ PNT 1
BACK SIGHT AT PNT 2

PNT	ANGLE RIGHT	HORIZ DIST.
2	00-00-00	87.67
3	48-48-43	45.30
4	310-17-43	23.49

⊗ SET CUT "X" IN TOP OF CURB

● FOUND 5/8" REBAR WITH BROKEN ORANGE CAP DOWN 2" PER SURVEY NUMBER 17637

○ FOUND 3/4" REBAR SEVERELY BENT WESTERLY PER SURVEY NUMBER 17637

0 30 60

SCALE 1"=30

SURVEY NARRATIVE TO COMPLY WITH O.R.S. 209.250

SURVEY FOR/BY: CITY OF MEDFORD, 411 WEST 8TH STREET, MEDFORD, OREGON 97501

DATE OF SURVEY: DECEMBER, 2019

PURPOSE: IN ACCORDANCE O.R.S. 209.150 THE PURPOSE OF THIS SURVEY IS TO PERPETUATE EXISTING MONUMENTATION FROM FILED SURVEYS OF RECORD ALONG DELTA WATERS ROAD RIGHT OF WAY WITHIN PROJECT LIMITS. THIS SURVEY WAS MADE AS A RESULT OF THE DELTA WATERS SIDEWALK INFILL PROJECT M19-00008. SAID PROJECT LIMITS ARE APPROXIMATELY 570' EAST OF CRATER LAKE AVENUE ON THE NORTH RIGHT OF WAY AND APPROXIMATELY 370' EAST ON THE SOUTH RIGHT OF WAY.

PROCEDURE: UTILIZING A TRIMBLE S6 ROBOTIC TOTAL STATION, CONTROL WAS SET AS SHOWN HEREON FOR THIS SURVEY. FROM SAID CONTROL REDUNDANT MEASUREMENTS WERE MADE AS SHOWN TO FOUND MONUMENTS PRIOR TO POSSIBLE DESTRUCTION.

371W08CC TL1200

REGISTERED PROFESSIONAL LAND SURVEYOR
2/10/20
OREGON
JANUARY 9, 2007
JON M. PROUD
77652
EXPIRES DECEMBER 2020

CITY OF MEDFORD - SURVEYING DEPARTMENT

DELTA WATERS ROAD

DRAWN BY: ZPE	DATE 12/26/2019	PROJECT NO.	
CHECKED BY: JP	DATE 12/31/2019	M19-00008	
DATE REFERENCED: 12/19/19	DATE		
CREW: Z. EARLE, S. METZGER		SHEET NO.	
		1 OF 1	

23017