23021

RECORD OF MONUMENT PRESERVATION

LOCATED IN THE NORTHEAST 1/4 OF SECTION 25, TOWNSHIP 37 SOUTH, RANGE 2 WEST, WILLAMETTE MERIDIAN, IN THE CITY OF MEDFORD, JACKSON COUNTY, OREGON

** RECEIVED **
DATE 2/21/20 BY PB
This survey consists of:
1 sheet(s) Map
0 page(s) Narrative
JACKSON COUNTY SURVEYOR

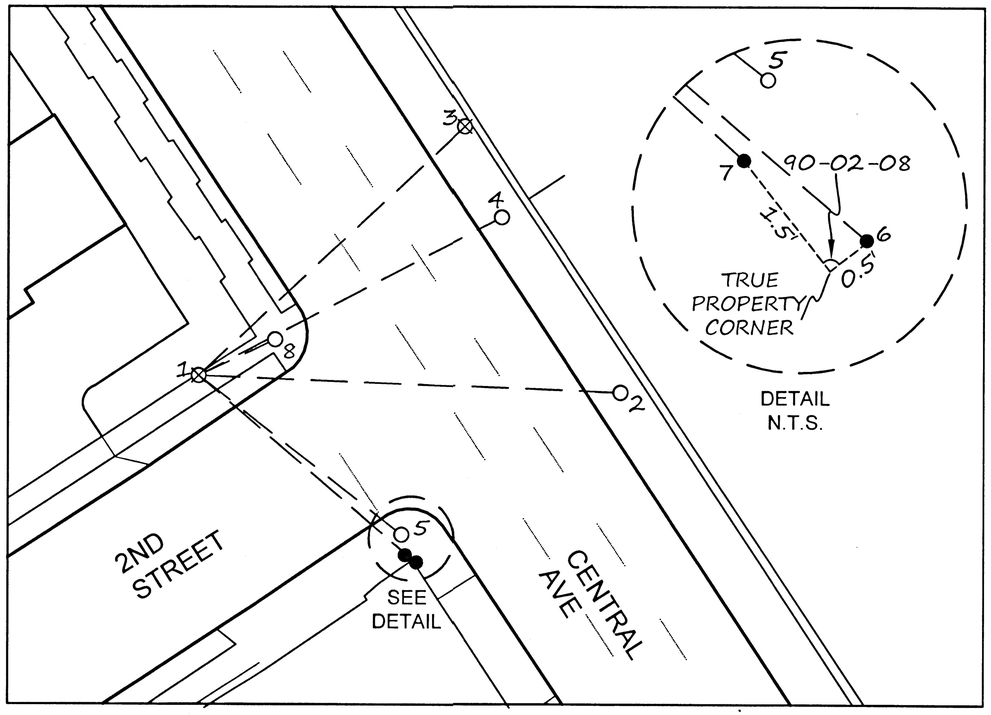

SET UP @ PNT 1
BACKSIGHT AT PNT 2

PNT	ANGLE RIGHT	HORIZ DIST.
2	00-00-00	88.40
3	314-25-20	76.24
4	329-58-33	71.55
5	35-43-15	54.06
6	38-41-40	60.10
7	38-46-17	58.55
8	332-20-04	17.72

⊠ SET CUT "X" IN SIDEWALK

● FOUND BRASS NAIL IN LEAD WITH 3/4" BRASS WASHER STAMPED "LS 2189" PER SURVEY NUMBER 22607 (2 WITNESS MONUMENTS TO TRUE CORNER PER SN 22607)

○ FOUND .38 CALIBER SHELLS PER SURVEY NUMBER 14947

0 30 60
SCALE 1"=30'

SURVEY NARRATIVE TO COMPLY WITH O.R.S. 209.250

SURVEY FOR/BY: CITY OF MEDFORD, 411 WEST 8TH STREET, MEDFORD, OREGON 97501

DATE OF SURVEY: DECEMBER, 2019

PURPOSE: IN ACCORDANCE O.R.S. 209.150 THE PURPOSE OF THIS SURVEY IS TO PERPETUATE EXISTING MONUMENTATION FROM FILED SURVEYS OF RECORD AT THE INTERSECTION OF 2ND STREET AND CENTRAL AVENUE PRIOR TO CONCRETE RAMP RECONSTRUCTION AND ROAD ASPHALT OVERLAYS.

UTILIZING A TRIMBLE S6 ROBOTIC TOTAL STATION, CONTROL WAS SET AS SHOWN HEREON FOR THIS SURVEY. FROM SAID CONTROL REDUNDANT MEASUREMENTS WERE MADE AS SHOWN TO FOUND MONUMENTS PRIOR TO DESTRUCTION

REGISTERED PROFESSIONAL LAND SURVEYOR
2/21/20
OREGON
JANUARY 9, 2007
JON M. PROUD
77652
EXPIRES DECEMBER 2020

372W25AA TL300

CITY OF MEDFORD - SURVEYING DEPARTMENT		
2ND STREET AND CENTRAL AVENUE		
DRAWN BY: ZPE	DATE 1/10/2020	PROJECT NO.
CHECKED BY: JP	DATE 1/10/2020	N/A
DATE REFERENCED:	DATE 12/30/19	
CREW: Z. EARLE, S. METZGER		SHEET NO.
		1 OF 1

23021