23023

RECORD OF MONUMENT PRESERVATION

LOCATED IN THE SOUTHEAST 1/4 OF SECTION 24, TOWNSHIP 37 SOUTH, RANGE 2 WEST, WILLAMETTE MERIDIAN, IN THE CITY OF MEDFORD, JACKSON COUNTY, OREGON

** RECEIVED **
DATE 2/21/20 BY PB
This survey consists of:
1 sheet(s) Map
5 page(s) Narrative
JACKSON COUNTY SURVEYOR

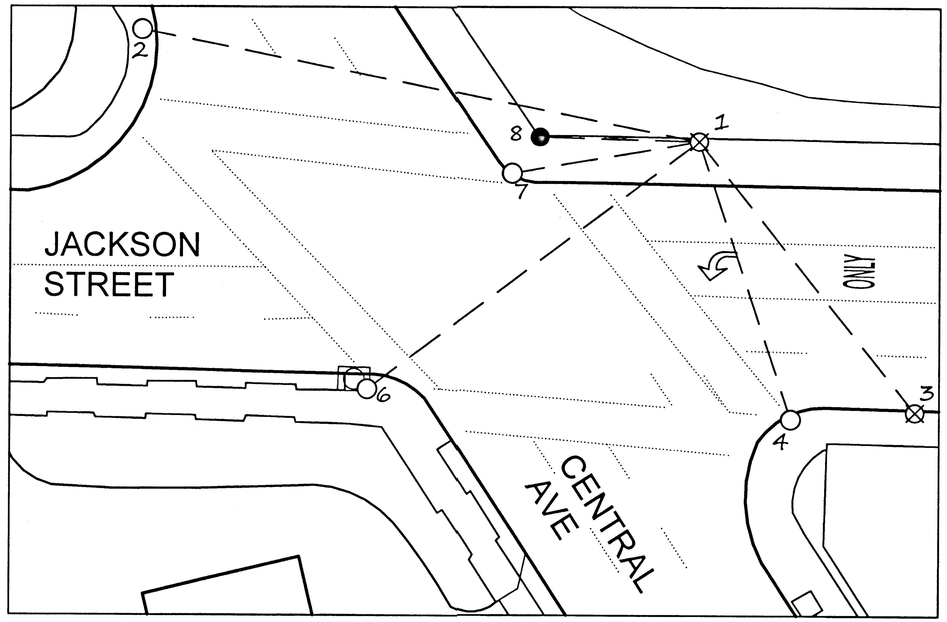

SET UP @ PNT 1
BACKSIGHT AT PNT 2

PNT	ANGLE RIGHT	HORIZ DIST.
2	00-00-00	119.04
3	219-52-53	72.58
4	240-09-54	61.32
6	311-47-32	86.57
7	338-50-01	39.72
8	350-08-43	33.37

⊗ SET CUT "X" IN CONCRETE

● FOUND 5/8" REBAR WITH CAP DOWN 2" PER SURVEY NUMBER 1689 & 16876

○ FOUND .40 CALIBER SHELLS WITH CITY OF MEDFORD TAG & TACK PER CITY OF MEDFORD RP NOTES RP25

0 30 60

SCALE 1"=30'

SURVEY NARRATIVE TO COMPLY WITH O.R.S. 209.250

SURVEY FOR/BY: CITY OF MEDFORD, 411 WEST 8TH STREET, MEDFORD, OREGON 97501

DATE OF SURVEY: DECEMBER, 2019

PURPOSE: IN ACCORDANCE O.R.S. 209.150 THE PURPOSE OF THIS SURVEY IS TO PERPETUATE EXISTING MONUMENTATION FROM FILED SURVEYS OF RECORD AT THE INTERSECTION OF JACKSON STREET AND CENTRAL AVENUE PRIOR TO CONCRETE RAMP RECONSTRUCTION AND ROAD ASPHALT OVERLAYS.

UTILIZING A TRIMBLE S6 ROBOTIC TOTAL STATION, CONTROL WAS SET AS SHOWN HEREON FOR THIS SURVEY. FROM SAID CONTROL REDUNDANT MEASUREMENTS WERE MADE AS SHOWN TO FOUND MONUMENTS PRIOR TO DESTRUCTION

REGISTERED PROFESSIONAL LAND SURVEYOR
2/14/20
OREGON
JANUARY 9, 2007
JON M. PROUD
77652
EXPIRES DECEMBER 2020

372W24DD TL5200

CITY OF MEDFORD - SURVEYING DEPARTMENT

JACKSON STREET AND CENTRAL AVENUE

DRAWN BY: ZPE	DATE 1/13/20	PROJECT NO.
CHECKED BY: JP	DATE 1/13/20	N/A
DATE REFERENCED: 12/30/2019	DATE	
CREW: Z. EARLE, S. METZGER		SHEET NO.
		1 OF 1

23023