

**SURVEY NARRATIVE:**

THE PURPOSE OF THIS SURVEY IS TO POST AND BLAZE THE LINE BETWEEN TAX LOTS 34-2W 2100 AND 34-2W 2200 & 2202, AS SHOWN IN BOLD HEREON. IT IS ALSO THE PURPOSE OF THIS SURVEY TO SET MONUMENTS AT TWO CORNERS OF THE LATHROP LANDS SHOWN HEREON.

USING FOUND MONUMENTS AS SHOWN, I RETRACED THE LINE BETWEEN SECTIONS 8 AND 9 AND SET THREE MONUMENTS FOR DEED CORNERS AS DESCRIBED IN D.N.s 2017-010772, 91-11756, AND 92-06338.

THIS SURVEY WAS CONDUCTED USING A TOPCON GTS 3003W TOTAL STATION AND TOPCON HIPER AND GR3 STATIC GPS RECEIVERS. THE FIELD SURVEY COMMENCED FEB. 18, 2020 AND WAS COMPLETED FEB. 21, 2020.

THE BASIS OF BEARINGS FOR THIS SURVEY IS GEODETIC (NAD83), AT THE CORNER OF SECTIONS 8, 9, 16, & 17 SHOWN HEREON, BASED ON STATIC GPS OBSERVATIONS TO CONTINUOUSLY OPERATING REFERENCE STATIONS (EPOCH 2010.00).

ALL FIELD BEARINGS AND DISTANCES TO BEARING TREES ARE TO THE CENTER OF THE TREE AT THE GROUND.

1/4 CORNER OF SECTIONS 7 & 8:  
FOUND BLM 2" I.D. IRON POST WITH 3 1/4" BC STAMPED "T34S R2W 1/4 S7 S8 1983", 10" ABOVE GROUND, IN A 3' STONE COLLAR, PER R6 & R7, FROM WHICH BEARS:

28" YP STUMP, BURNED, S81 1/2°W 36.1' (S80°W 35.6' R6).  
FIR STUMP REMAINS, BURNED, S30°W 57.2' (S38 1/2°W 57.4' R6).  
6" DF MARKED "XBT" THIS SURVEY N79°W 9.7'.

JOHN HANCOCK  
LIFE INSURANCE  
COMPANY (U.S.A.)  
D.N. 2017-010772  
34-2W, T.L. 2100

CORNER OF SECTIONS 4, 5, 8, & 9:  
FOUND GLO 2" O.D. IRON POST WITH 2 1/2" BC STAMPED "T34S R2W S4 S5 S8 S9 1928", 6" ABOVE GROUND, PER R1, R4, & R5, FROM WHICH BEARS:

30" MD WITH HB N39 1/2°E 39.3' F=R5 (N40°E 39.6' R4)  
25" BO WITH HB S11°E 54.8' F=R4  
12" DF WITH HB S50°W 16.65' F=R5  
28" MD WITH HB N65°W 42.0' F=R5

1/4 CORNER OF SECTIONS 8 & 9:  
FOUND NO EVIDENCE OF THE ORIGINAL GLO CORNER. SET 5/8" REBAR, 30" LONG, 24" IN THE GROUND, WITH 2 1/2" AC STAMPED "T34S R2W 1/4 S8 S9 2020 PLS 77662", FROM WHICH BEARS:

9" DF MARKED "XBT" THIS SURVEY S30°E 12.8'.  
9" DF MARKED "XBT" THIS SURVEY S38°W 2.5'.

S 1/16 CORNER OF SECTIONS 8 & 9:  
SET 5/8" REBAR, 30" LONG, 26" IN THE GROUND, WITH 2 1/2" AC STAMPED "T34S R2W S 1/16 S8 S9 2020 PLS 77662", FROM WHICH BEARS:

4" WO MARKED "XBT" THIS SURVEY S76°E 16.8'.

S-S 1/64 CORNER OF SECTIONS 8 & 9:  
SET 5/8" REBAR, 30" LONG, 30" IN THE GROUND IN AN EXISTING DRIVEWAY, WITH 2 1/2" AC STAMPED "T34S R2W S-S 1/64 S8 S9 2020 PLS 77662".

CORNER OF SECTIONS 8, 9, 16, & 17:  
FOUND 2 1/2" BC STAMPED "T34S R2W 8 9 16 17 C.S. 1994", FLUSH WITH GROUND, PER R3 & R8, FROM WHICH BEARS:

14" WO WITH HB N50 3/4°E 41.8' F=R3.  
28" BO STUMP N55°E 62.7' F=R3.  
25" DF STUMP N56 1/4°E 73.9' F=R3.  
8" BO WITH HB N24°W 44.0' F=R3.  
10" BO WITH HB S62 1/4°W 44.1' F=R3.  
10" WO WITH HB S32 1/4°E 61.8' F=R3.

S7

S8

N89°43'48"E 5243.18'

RODEN  
D.N. 88-13652  
34-2W, T.L. 2202

RODEN  
D.N. 88-13652  
34-2W, T.L. 2200

GRAY  
D.N. 2010-015796  
34-2W-09,  
T.L. 402



LINNELL  
D.N. 03-80446  
34-2W-09,  
T.L. 500

LATHROP  
D.N. 92-06338  
34-2W-09,  
T.L. 1000

LATHROP  
D.N. 91-11756  
34-2W-09,  
T.L. 1100

**LEGEND OF SYMBOLS & ABBREVIATIONS**

- FOUND MONUMENT AS NOTED.
- ⊙ SET MONUMENT AS NOTED.
- AC ALUMINUM CAP
- BC BRASS CAP
- BLM BUREAU OF LAND MANAGEMENT
- BO BLACK OAK
- DF DOUGLAS FIR
- D.N. DOCUMENT NUMBER
- F FIELD MEASUREMENT
- HB HEALED BLAZE
- I.D. INSIDE DIAMETER
- MD MADRONE
- O.D. OUTSIDE DIAMETER
- WO WHITE OAK
- ( ) INDICATES RECORD DATA

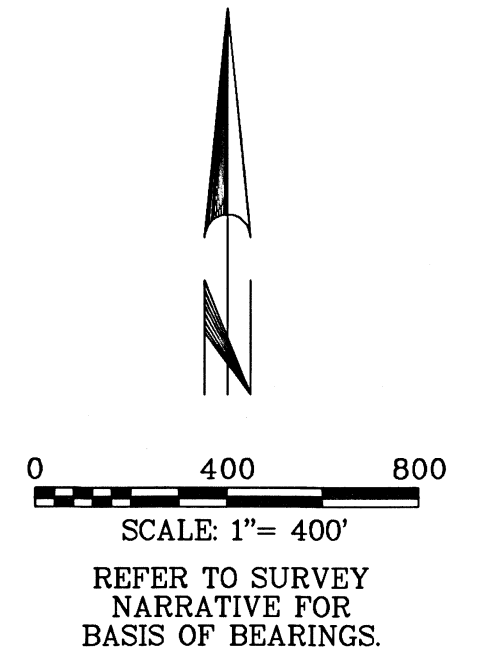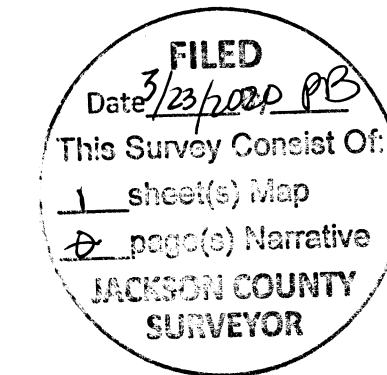

**REFERENCES:**

- R1 = CS 10233
- R2 = GLO PLAT FOR T.34S., R.2W., APPROVED 11/5/1857.
- R3 = BLM 2009-2010 SURVEY OF SECTIONS 16 & 17, T.34S., R.2W., W.M.
- R4 = GLO 1928 SURVEY BY HERBERT N. RAYMOND.
- R5 = CS FIRST REESTABLISHMENT OF NORTHEAST CORNER OF SEC. 8, T.34S., R.2W., W.M. (1989).
- R6 = BLM 1963 REMONUMENTATION NOTES BY JOSEPH S. GAWRON.
- R7 = CS 3220
- R8 = CS FIRST REESTABLISHMENT OF SOUTHEAST CORNER OF SEC. 8, T.34S., R.2W., W.M. (1994).

REGISTERED  
PROFESSIONAL  
LAND SURVEYOR

*Gregg Arnold Neitsch*

OREGON  
JULY 11, 2006  
GREGG ARNOLD NEITSCH  
77662LS

EXPIRES: 12/31/2020

**MAP OF SURVEY**

FOR  
HANCOCK FOREST MANAGEMENT  
&  
LEWIS LATHROP

THE CENTERLINE AND EAST LINE OF  
SECTION 8, T. 34 S., R. 2 W., W.M.,  
JACKSON COUNTY, OREGON

NORTH STATE LAND SURVEYING  
1511 KYLYNN CT.  
MOUNT SHASTA, CA

FEBRUARY 2020 SCALE: 1"=400' SHEET 1 OF 1  
COWGND.ASC COWBELL MOS.GXD JOB NO. 615