


2309

Survey For:
ORAN C. CHASTAIN & EARNEST GREGG
Located in Blocks 21 & 22
Fryers Division of
Eagle Point, Oregon
By: Mark E. Boyden
Sept. 1963

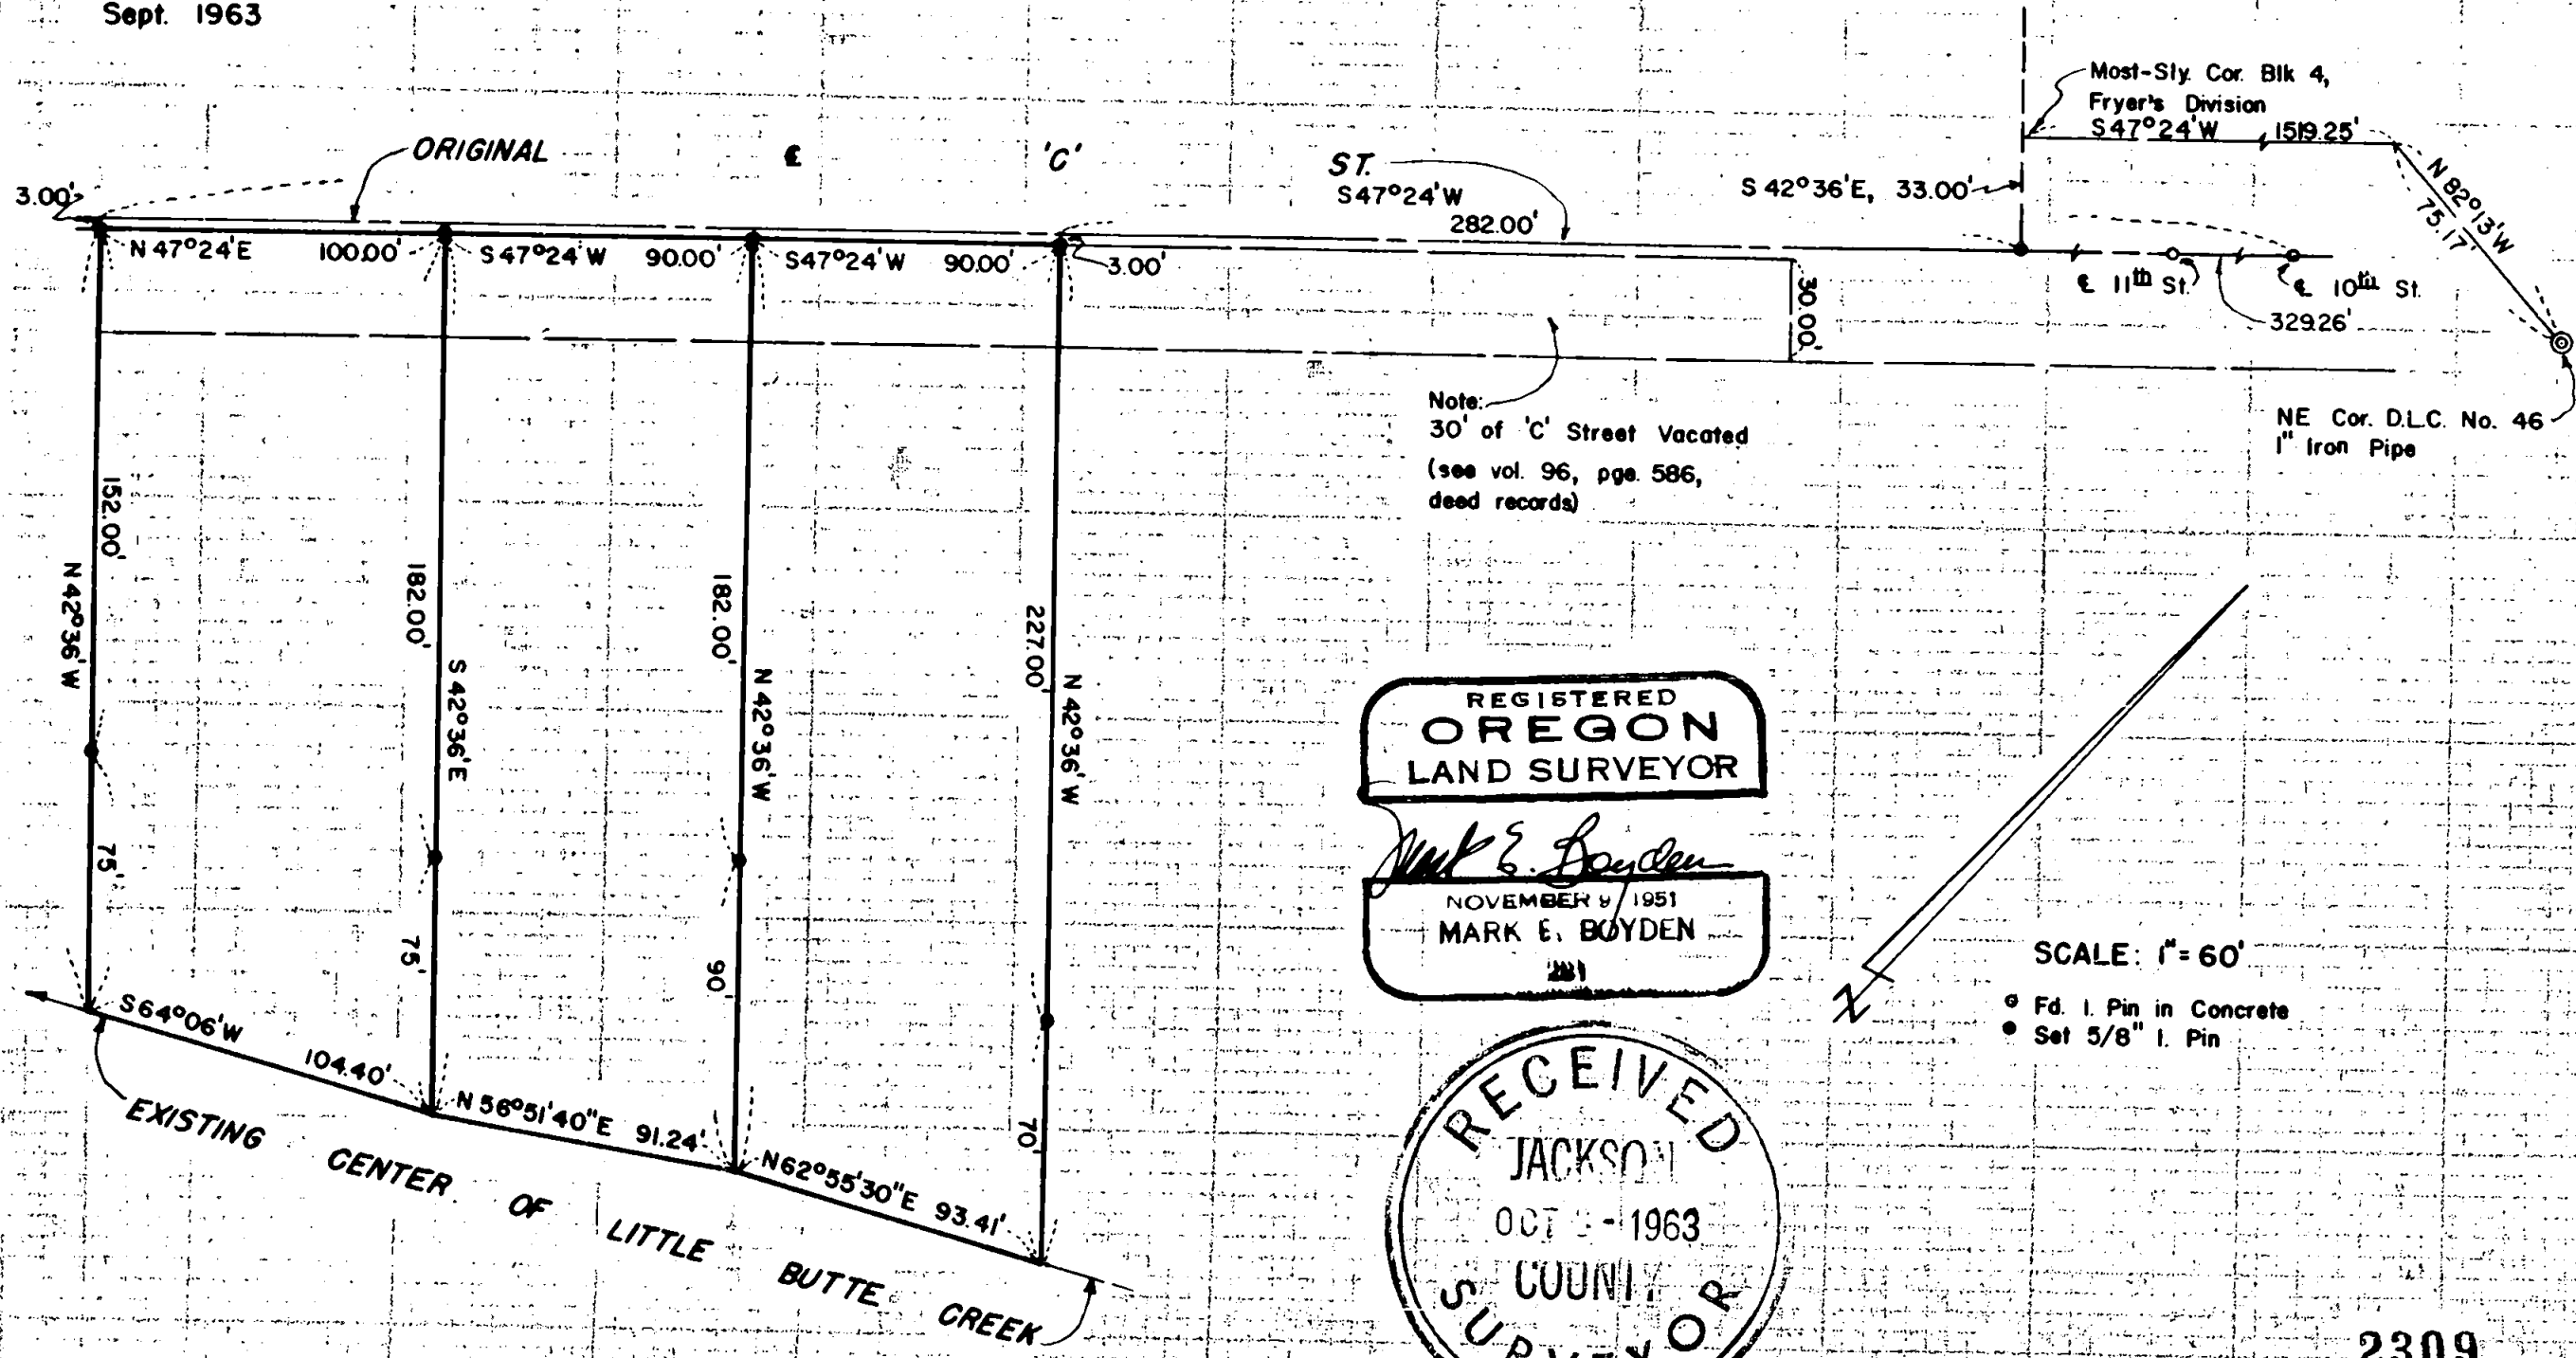


Note:
30' of 'C' Street Vacated
(see vol. 96, pgs. 586,
deed records)

REGISTERED
OREGON
LAND SURVEYOR

Mark E. Boyden
NOVEMBER 8 1951
MARK E. BOYDEN
231

RECEIVED
JACKSON
OCT 8 - 1963
COUNTY
SURVEYOR

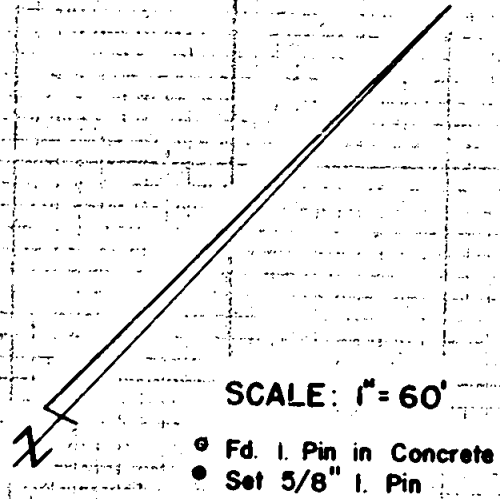

2309

SURVEY NARRATIVE TO COMPLY WITH O.R.S. 209.250

FOR: Oran C. Chastain &
Earnest Gregg
811 South "C" Street
Eagle Point, Oregon

PURPOSE: To monument and describe three parcels lying in the Southwesterly portion of the Gregg ownership described in Volume 452, Page 455 of the Deed Records of Jackson County, Oregon.

PROCEDURE:

Found monuments set on Recorded Survey Nos. 1418 and 1595 for control of "C" Street and Block 4 of J.J. FRYERS DIVISION.

Monumented the Southwesterly boundary of the Gregg ownership deed record distance Southwesterly from the most-Southerly corner of Block 4. The side lines were established at right angles from "C" Street and parallel to the original block boundaries of J.J. FRYERS DIVISION.

If the bearing of "S42°E" appearing in more recent deeds was used for control, laps and gaps would appear along the boundaries of several ownerships in this area.

Monumented the parcels as shown, using for meridian control, the bearings established on Recorded Survey No. 1418.

September 1963

