

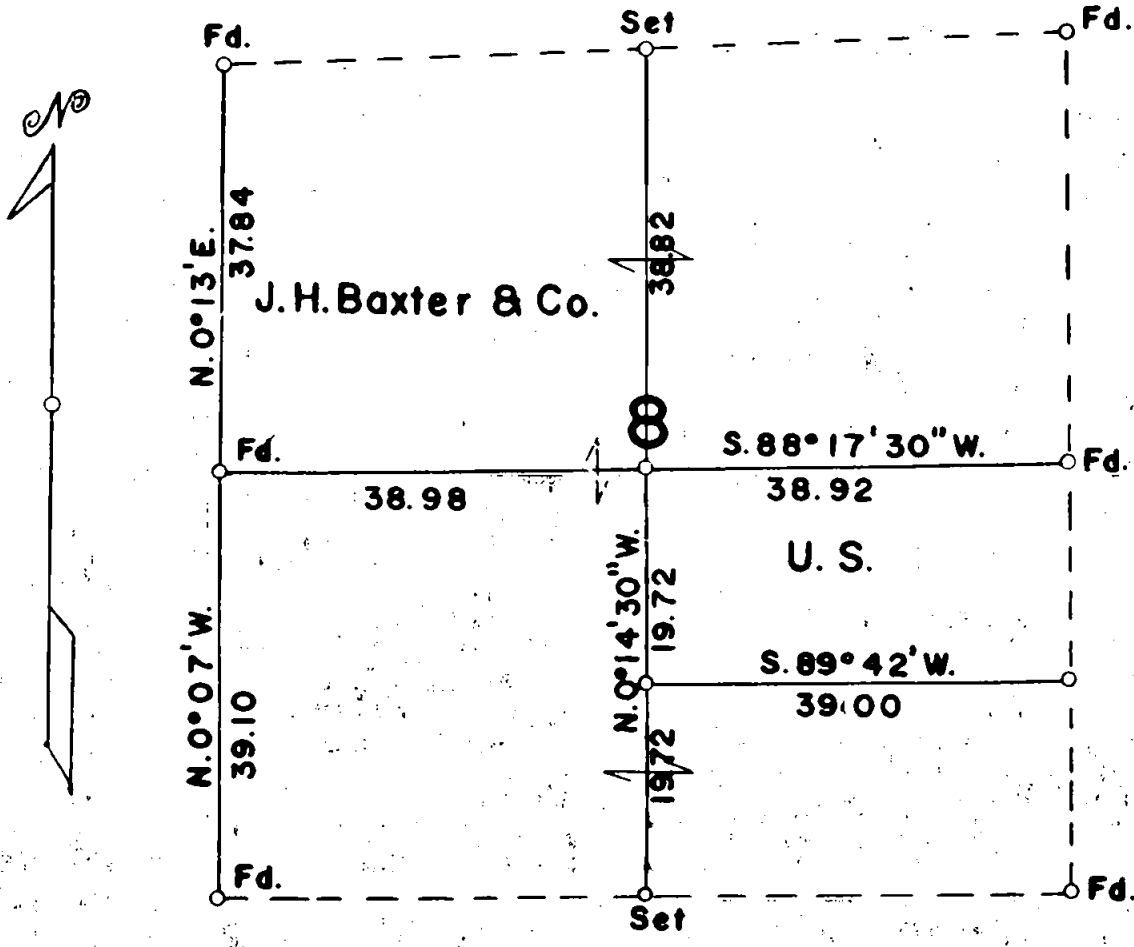


# T. 36S., R. 4W., JACKSON COUNTY OREGON

CORRECTION SURVEY IN SECTION 8

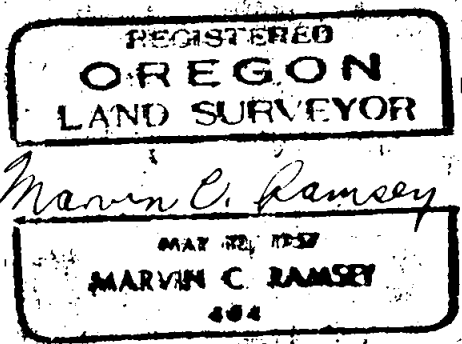

Scale: 1 Inch = 20 chains  
September 20, 1963

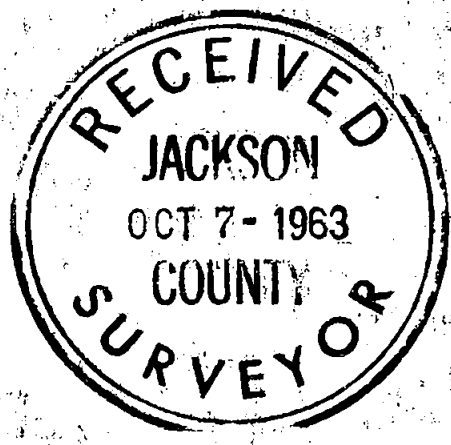

T. 36 S., R. 4 W.

The  $\frac{1}{4}$  sec. cor. of secs. 7 and 8 was erroneously set on account of an error in transcribing the original Government field notes.

I pulled up the iron pipe and reset it in the true position from which the only original bearing tree

A Douglas fir sawed stump 30 ins. in diam., bears N.  $40^{\circ}$  E., 20 lks. distance, from which new bearing trees

A Douglas fir 14 ins. in diam., bears S.  $35^{\circ}$  E.,  $84\frac{1}{2}$  lks. dist., mkd.  $\frac{1}{4}$  S8 RS404 BT

A Douglas fir 40 ins. in diam., bears N.  $83^{\circ}$  W., 37 lks. dist., mkd.  $\frac{1}{4}$  S7 RS404 BT

---

I pulled up the center South  $1/16$  sec. cor. and moved it 1 link North from which

A black oak 6 ins. in diam., bears S.  $2^{\circ}$  E., 8 lks. dist., mkd. CS  $1/16$  S8 RS404 BT

A madrona 8 ins. in diam., bears N.  $51\frac{1}{2}^{\circ}$  E.,  $92\frac{1}{2}$  lks. dist., mkd. CS  $1/16$  S8 RS404 BT

---



I pulled up the iron pipe at the center  $\frac{1}{4}$  sec. cor. and moved it 2 links North from which

A black oak 24 ins. in diam., bears N.  $53\frac{1}{2}^{\circ}$  E., 53 lks. dist., mkd. C  $\frac{1}{4}$  S8 RS404 BT


A black oak 6 ins. in diam., bears S.  $19\frac{1}{2}^{\circ}$  E., 32 lks. dist., mkd. C  $\frac{1}{4}$  S8 RS404 BT

A black oak 6 ins. in diam., bears S.  $30^{\circ}$  W., 19 lks. dist., mkd. C  $\frac{1}{4}$  S8 RS404 BT

A black oak 14 ins. in diam., bears N.  $41\frac{1}{4}^{\circ}$  W.,  $73\frac{1}{2}$  lks. dist., mkd. C  $\frac{1}{4}$  S8 RS404 BT

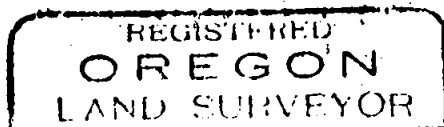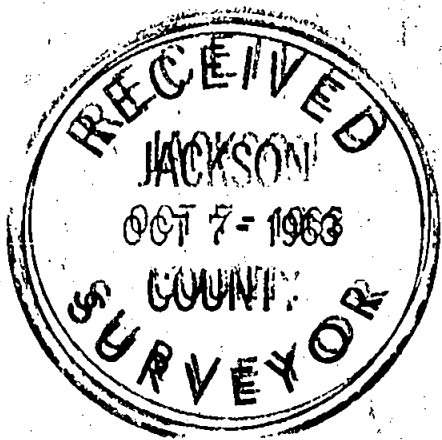

*Marvin C. Ramsey*

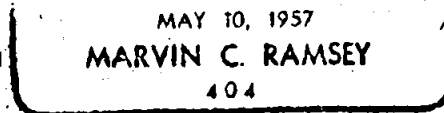

TOWNSHIP 36 SOUTH, RANGE 4 WEST, WILLAMETTE MERIDIAN  
JACKSON COUNTY, OREGON

CORRECTION SURVEY IN SECTION 8

EXECUTED AT THE REQUEST OF J. H. BAXTER & CO.

OF

GRANTS PASS, OREGON

BY

Marvin C. Ramsey, Registered Professional Land Surveyor

Assistants  
Paul E. Jonas  
Floyd H. Brock

September 20, 1963