

Survey for Olive D'Ann Note and Gerald W. Note  
1774 Old Stage Road, Medford, Oregon.

Located in Northwest Quarter Section 21, T 37S. R 2 W Jackson County.

September 1963.

Scale 1" = 100'


Bearings from previous survey at D.L.C. Corner.

REGISTERED  
OREGON  
LAND SURVEYOR

*L. N. Dow*

MAY 6, 1949  
L. N. DOW  
251

RECEIVED  
JACKSON  
OCT 13 1963  
COUNTY  
SURVEYOR

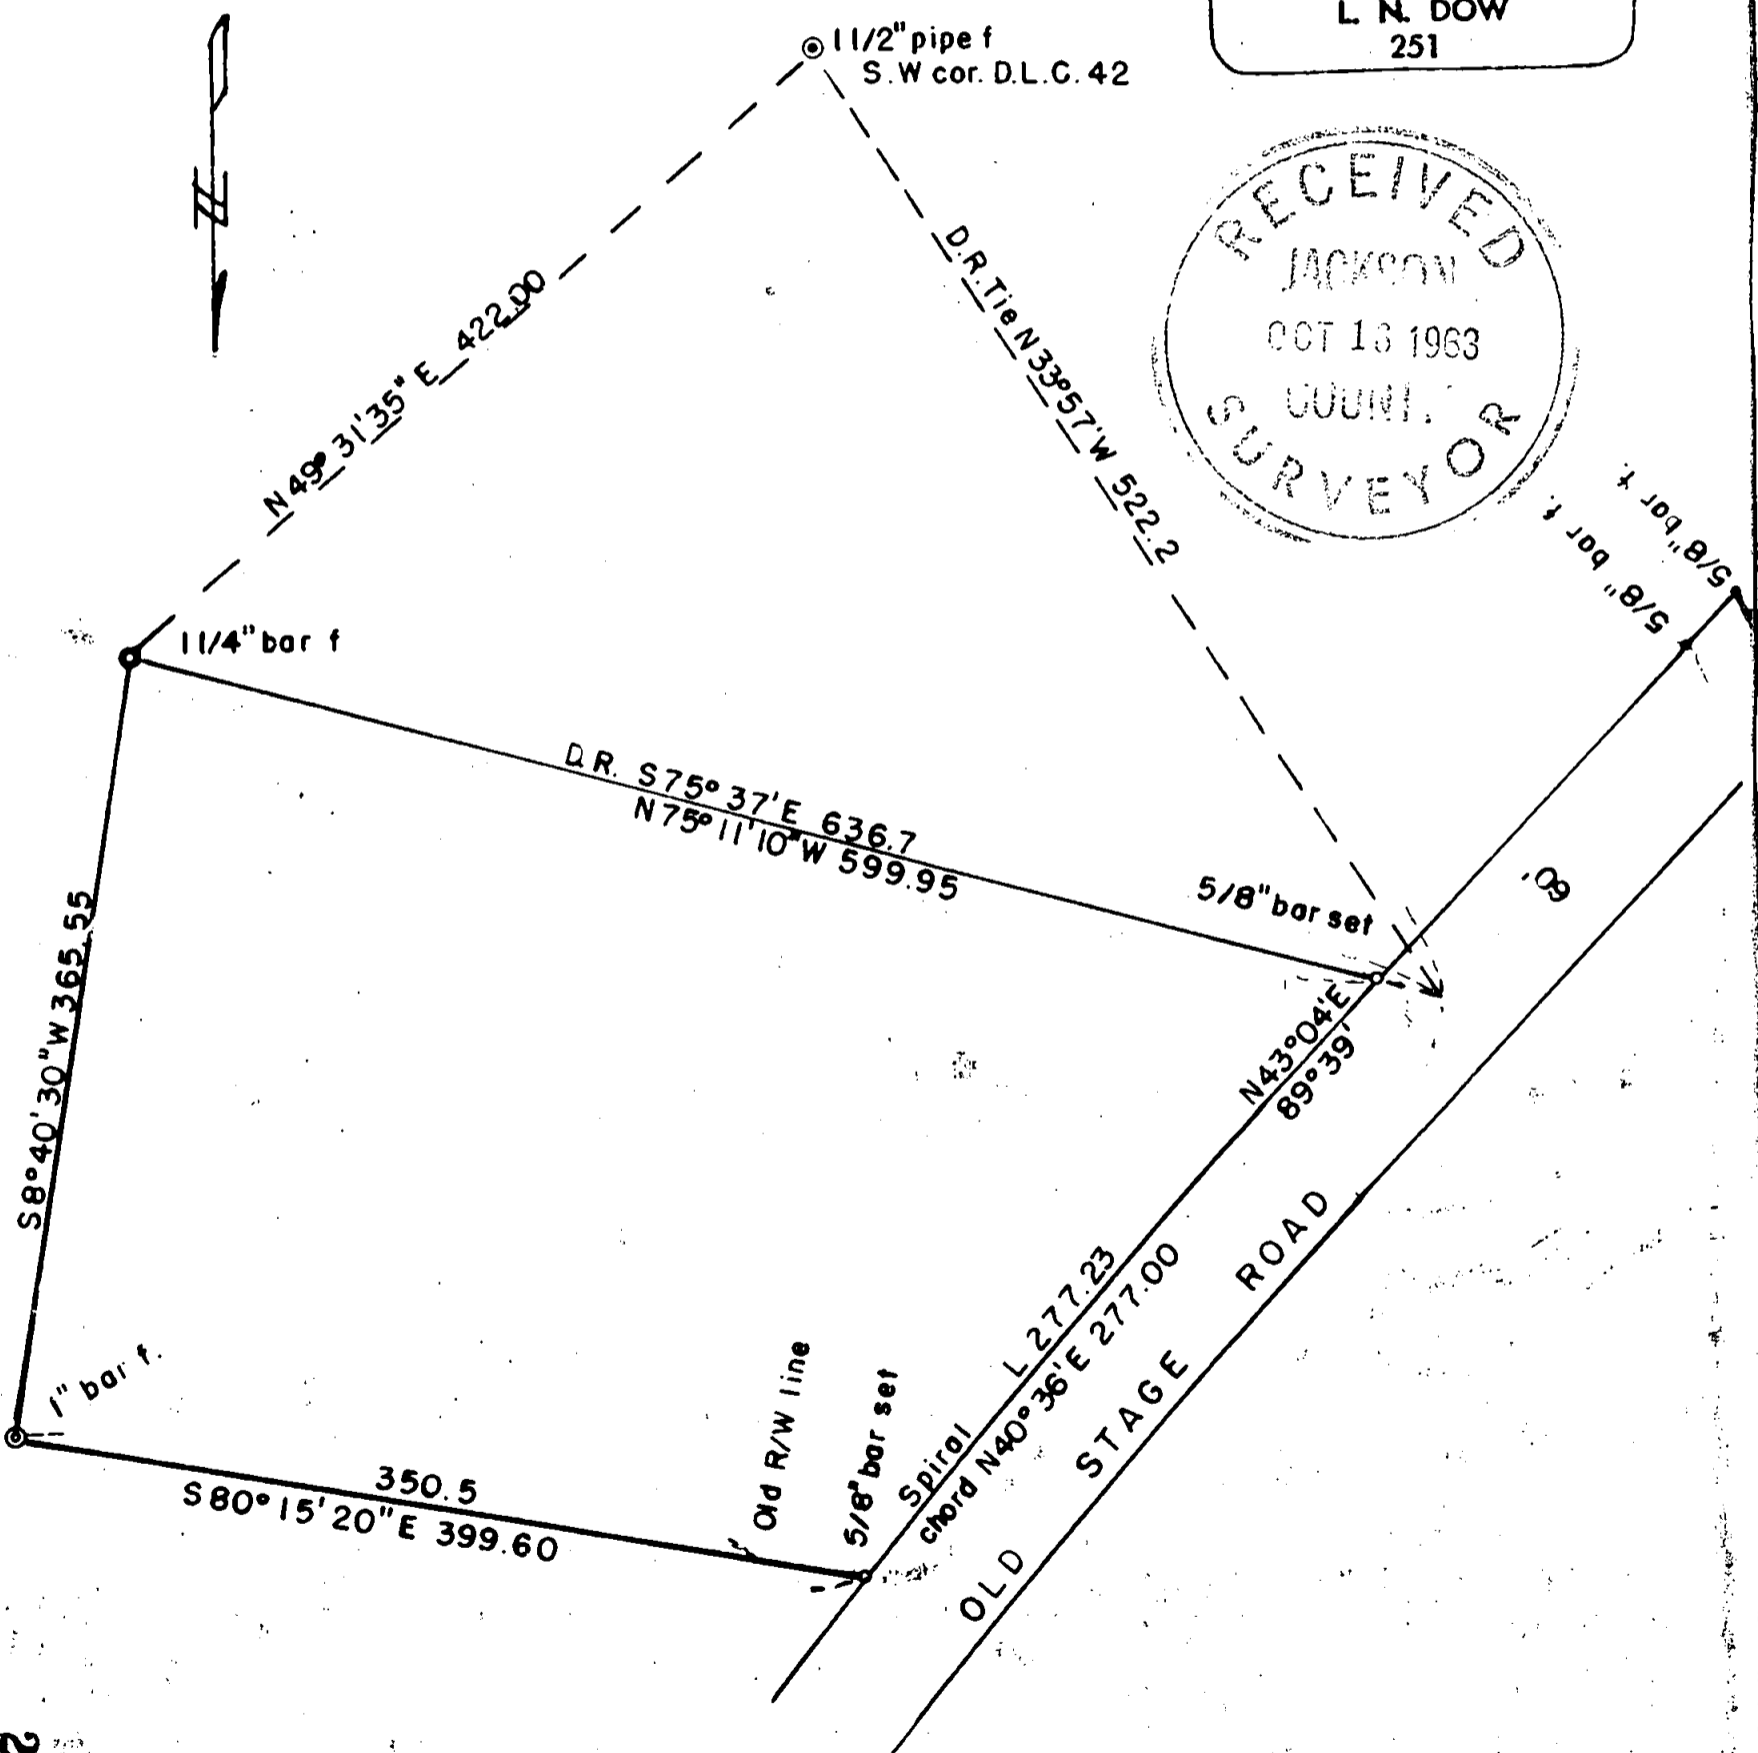

Written narrative to accompany plat for survey NO. 2318

Survey for Olive D' Ann Note and Gerald W. Note  
1774 Old Stage Road, Medford, Oregon.

Located in Northwest Quarter of Section 21, T 37S.R.2W.  
Jackson County, Oregon.

Date September 1963.

Purpose: to retrace original intent of written description and change lines to conform to existing fences, but include that part of the Old Stage Road lying immediately east of the recently constructed Old Stage Road through the subject property.

Found 1 1/2" pipe for the Southwest corner of Donation Land Claim No. 42.

Found 1 1/4" iron bar for the established southeast corner of tract.



Found a 1" iron bar for the established corner (northeast) of tract.

Found 5/8" bars at intervals along the easterly line of Old Stage Road to establish tangent line of road to south of survey

Found intersection bar at Old Stage Road and Ross Lane

With the above controls we made a tie from the D.L.C. corner to the established southeast corner of subject property. We then ran out record tie to the southwest corner of the original tract which now falls in the right of way of the Old Stage Road. next by intersection we set a 5/8" bar on the easterly right of way line of Old Stage Road on the south line of the subject property. then by setting up the two tangents and making an intersection for the point of intersection for the curve in front of the tract we set up the curve data and set a 5/8" bar on the easterly line of the right of way where the north line of tract intersects said right of way.

Bearings used from previous survey.

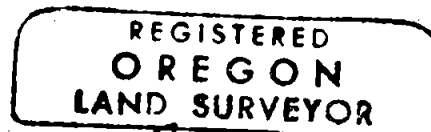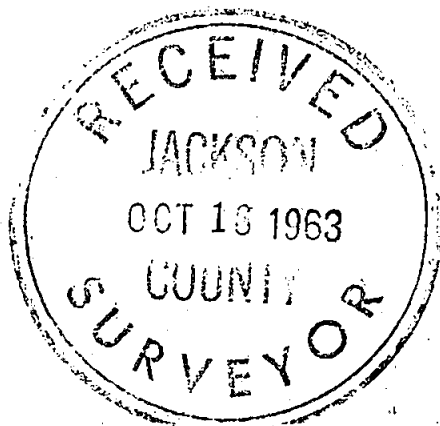

*L. N. Dow*

