NARRATIVE

THE PURPOSE OF THIS SURVEY IS TO AMEND THE SURVEY FILED AS COUNTY SURVEY NO. 21818. THE PURPOSE OF THIS REROUTE IS TO PLACE THE PROPOSED PIPELINE IN A MORE CONSTRUCTIBLE LOCATION. THIS SURVEY SHOWS ADDITIONAL INFORMATION FOR THE FOUND AND RECORD DATA BETWEEN EXISTING MONUMENTS. THIS SURVEY IS LOCATED IN SECTION 29, TOWNSHIP 33 SOUTH, RANGES 1 WEST, OF THE WILLAMETTE MERIDIAN.

THE TEMPORARY CONSTRUCTION EASEMENT WAS SURVEYED AND MONUMENTED BY THE DYER PARTNERSHIP. UNDER THE DIRECT SUPERVISION OF MICHAEL W. ERICKSON

SCALE FACTOR NOTE

THE DISTANCES SHOWN ON THIS SURVEY ARE GRID DISTANCES UNLESS NOTED THE COMBINED SCALE FACTOR = 0.999880457 TO CONVERT FROM GRID TO GROUND MULTIPLY THE DISTANCE BY 1.000119557.

EXAMPLE: 300.00' GRID DISTANCE $300.00' \times 1.000119557 = 300.04' GROUND$ DISTANCE.

BASIS OF BEARINGS

NAD 1983/91 (CONUS) OREGON SOUTH ZONE 3602 GRID NORTH (BASED ON PREVIOUSLY ESTABLISHED PROJECT CONTROL)

NOTE:

DISTANCES ARE IN US SURVEY FEET.

MEAN MERIDIAN CONVERGENCE ANGLE = -1°36'30 (THE CONVERGENCE ANGLE IS COMPUTED BY AVERAGING THE CONVERGENCE ANGLE AT THE NORTH 1/4 OF SECTION I, TOWNSHIP 33 SOUTH RANGE 2 WEST AND THE SOUTHEAST CORNER OF SECTION 33, TOWNSHIP 33 SOUTH RANGE 2 WEST)

SURVEYOR'S CERTIFICATE

, MICHAEL W. ERICKSON BEING DULY SWORN AS A PROFESSIONAL LAND SURVEYOR IN THE STATE OF OREGON DO HEREBY CERTIFY THAT THIS MAP CORRECTLY REPRESENTS A SURVEY CONDUCTED UNDER MY DIRECT SUPERVISION IN CONFORMANCE WITH THE REQUIREMENTS OF THE SURVEY RECORDING LAW, AS ESTABLISHED BY ORS CHAPTER 209, AND HAVE SET THE PROPER MONUMENTS AS REFERENCED IN THE LEGEND BY MY REGISTRATION NUMBER AND SEAL.

FURTHERMORE, I APPROVE THE LOCATION OF THE MONUMENTS AS DEPICTED ON THIS SURVEY DRAWING TO BE IN THEIR PROPER LOCATION.





CORNER NOTES:

CORNERS VISITED DURING FILED MAP NO. 21818

REFERENCE C.S. 8781 BLM GROUP 803, VOL. OR-R0619, PAGES 475, 476

FOUND 5/8" REBAR BT REFERENCES: 1) FOUND 26" FIR SNAG WITH HEALED FACE N 22' E - 12.5' TO FACE TREE

(RECORD 11" D. FIR - N 22' E, 11.8')

THIS REBAR WAS SET USING THE 1973 BLM MONUMENT FOR THE N 1/4 OF SECTION 29, REMOVED BY THE BLM IN 1982. SEE BOTH REFERENCES ABOVE FOR THIS SURVEY WE ARE ACCEPTING THE JACKSON COUNTY 1/4 CORNER, WHICH WAS APPROVED BY

(141618)

REFERENCE GCDB 240300 1/4 CORNER COMMON TO SECTIONS 20 AND 29 FOUND 2-1/2" BRASS CAP STAMPED JACKSON COUNTY

DATED 1981 BT REFERENCES: 1) FOUND 8" CEDAR

THE BLM IN 1983.

N 40° E, 21.3' (RECORD 7" CEDAR, - N 39-3/4" E, 21.1') 2) FOUND 10" PINE WITH VISIBLE SCRIBING S 49° W - 34.3' (RECORD 9" PINE, - S 47-1/4" W, 34.1') 3) FOUND 9" MADRONE WITH VISIBLE SCRIBING

N 23° W - 20.8' (RECORD 8" MADRONE - N 24-1/4" W, 20.8')

REFERENCE BLM GROUPS 350 AND 803, VOLUME OR-R0604, PAGE 133 CORNER OF SECTIONS 19, 20, 20, & 30 FOUND 3-1/4" BLM BRASS CAP DATED 1973

BT REFERENCES 1) FOUND 29" FIR WITH HEALED FACE AND TAG DATED 9/87 N 24-1/4° E - 8.2' (RECORD 21" FIR - N 25' E, 7.92')

2) FOUND 24" STUMP 5' TALL

S 81-1/2° E - 16.8' (RECORD 24" FIR - S 24" E, 15.84') 3) FOUND 27" FIR WITH HEALED FACE

AND TAG DATED 9/87 S 81-1/2° E - 32.1' (RECORD 23" FIR - S 81-1/4" E, 32.34")4) FOUND 11" FIR WITH HEALED FACE

AND TAG DATED 9/87 S 46-3/4° W - 40.8' (RECORD 5" FIR - S 46-3/4" W, 40.8")5) FOUND 18" FIR WITH HEALED FACE

AND TAG DATED 9/87 N 49-1/4° W - 30.7° (RECORD 14" FIR - N 49" W, 38.94')

(141631)

REFERENCE BLM GROUPS 350 AND 803, VOLUME OR-R0604, PAGE 131 1/4 CORNER SECTIONS 29 AND 32 FOUND 3-1/4" BLM BRASS CAP DATED 1973

BT REFERENCES: 1) FOUND 10" P. PINE WITH HEALED FACE N 24° E - 31.4' TO NAIL SIDE CENTER (RECORD 7" PINE - N 214° E, 31.52') 2) FOUND 17" D. FIR WITH HEALED FACE

AND TAG DATED 5/73 S 20-1/2° W - 15.2' (RECORD 13" FIR - S 30-1/2" W - 15.18")

REFERENCE SURVEYS:

1) ORIGINAL GLO PLAT T32S-R2W -APPROVED JULY 7, 1856

2) COUNTY SURVEY NO. 15719, FILED MAY 4, 1998

3) BLM DEPENDENT RESURVEY CS NO. 5823, APPROVED JULY 15, 1982

4) COUNTY SURVEY NO. 12848, FILED JANUARY 28, 1992 5) BLM DEPENDENT RESURVEY CS NO. 5628 - APPROVED FEBRUARY 17, 1978

6) COUNTY SURVEY NO. CS 16239 - FILED AUGUST 9, 1999 7) COUNTY SURVEY NO. CS 13543 - FILED JUNE 15, 1993

8) BLM CORRECTIVE DEPENDENT RESURVEY CS NO. 5881, APPROVED JUNE 1, 1983

9) COUNTY SURVEY NO. 8781 - FILED APRIL 8, 1981

10) BLM DEPENDENT SURVEY CS NO. 6404 - APPROVED NOVEMBER 7, 1991

11) COUNTY SURVEY NO. 11633 - FILED JUNE 26, 1989 12) COUNTY SURVEY NO. 14084 - FILED JUNE 30, 1994

13) BLM DEPENDENT RESURVEY - APPROVED OCTOBER 8, 1970 (T35S-R2W)

14) COUNTY SURVEY NO. 11027 - FILED NOVEMBER 2, 1987

15) COUNTY SURVEY NO. 13959 - FILED APRIL 4, 1994 16) COUNTY SURVEY NO. 21818 - FILED OCTOBER 1, 2015

WILLAMETTE MERIDIAN JACKSON COUNTY, OREGON

T.33S., R.1W


SURVEY PERFORMED FOR: Pembina Pipeline Corporation 4000, 585 8th Avenue S.W. Calgary, AB T2P 1G1 DATE: OCTOBER 1, 2020 DRAFT: RAA FILE: RS-33S-01W_MP 119.DWG

MAP OF SURVEY

LOCATED IN THE

NW 1/4 OF SECTION 29 TOWNSHIP 33 SOUTH, RANGE 1 WEST, WILLAMETTE MERIDIAN

JACKSON COUNTY, OREGON

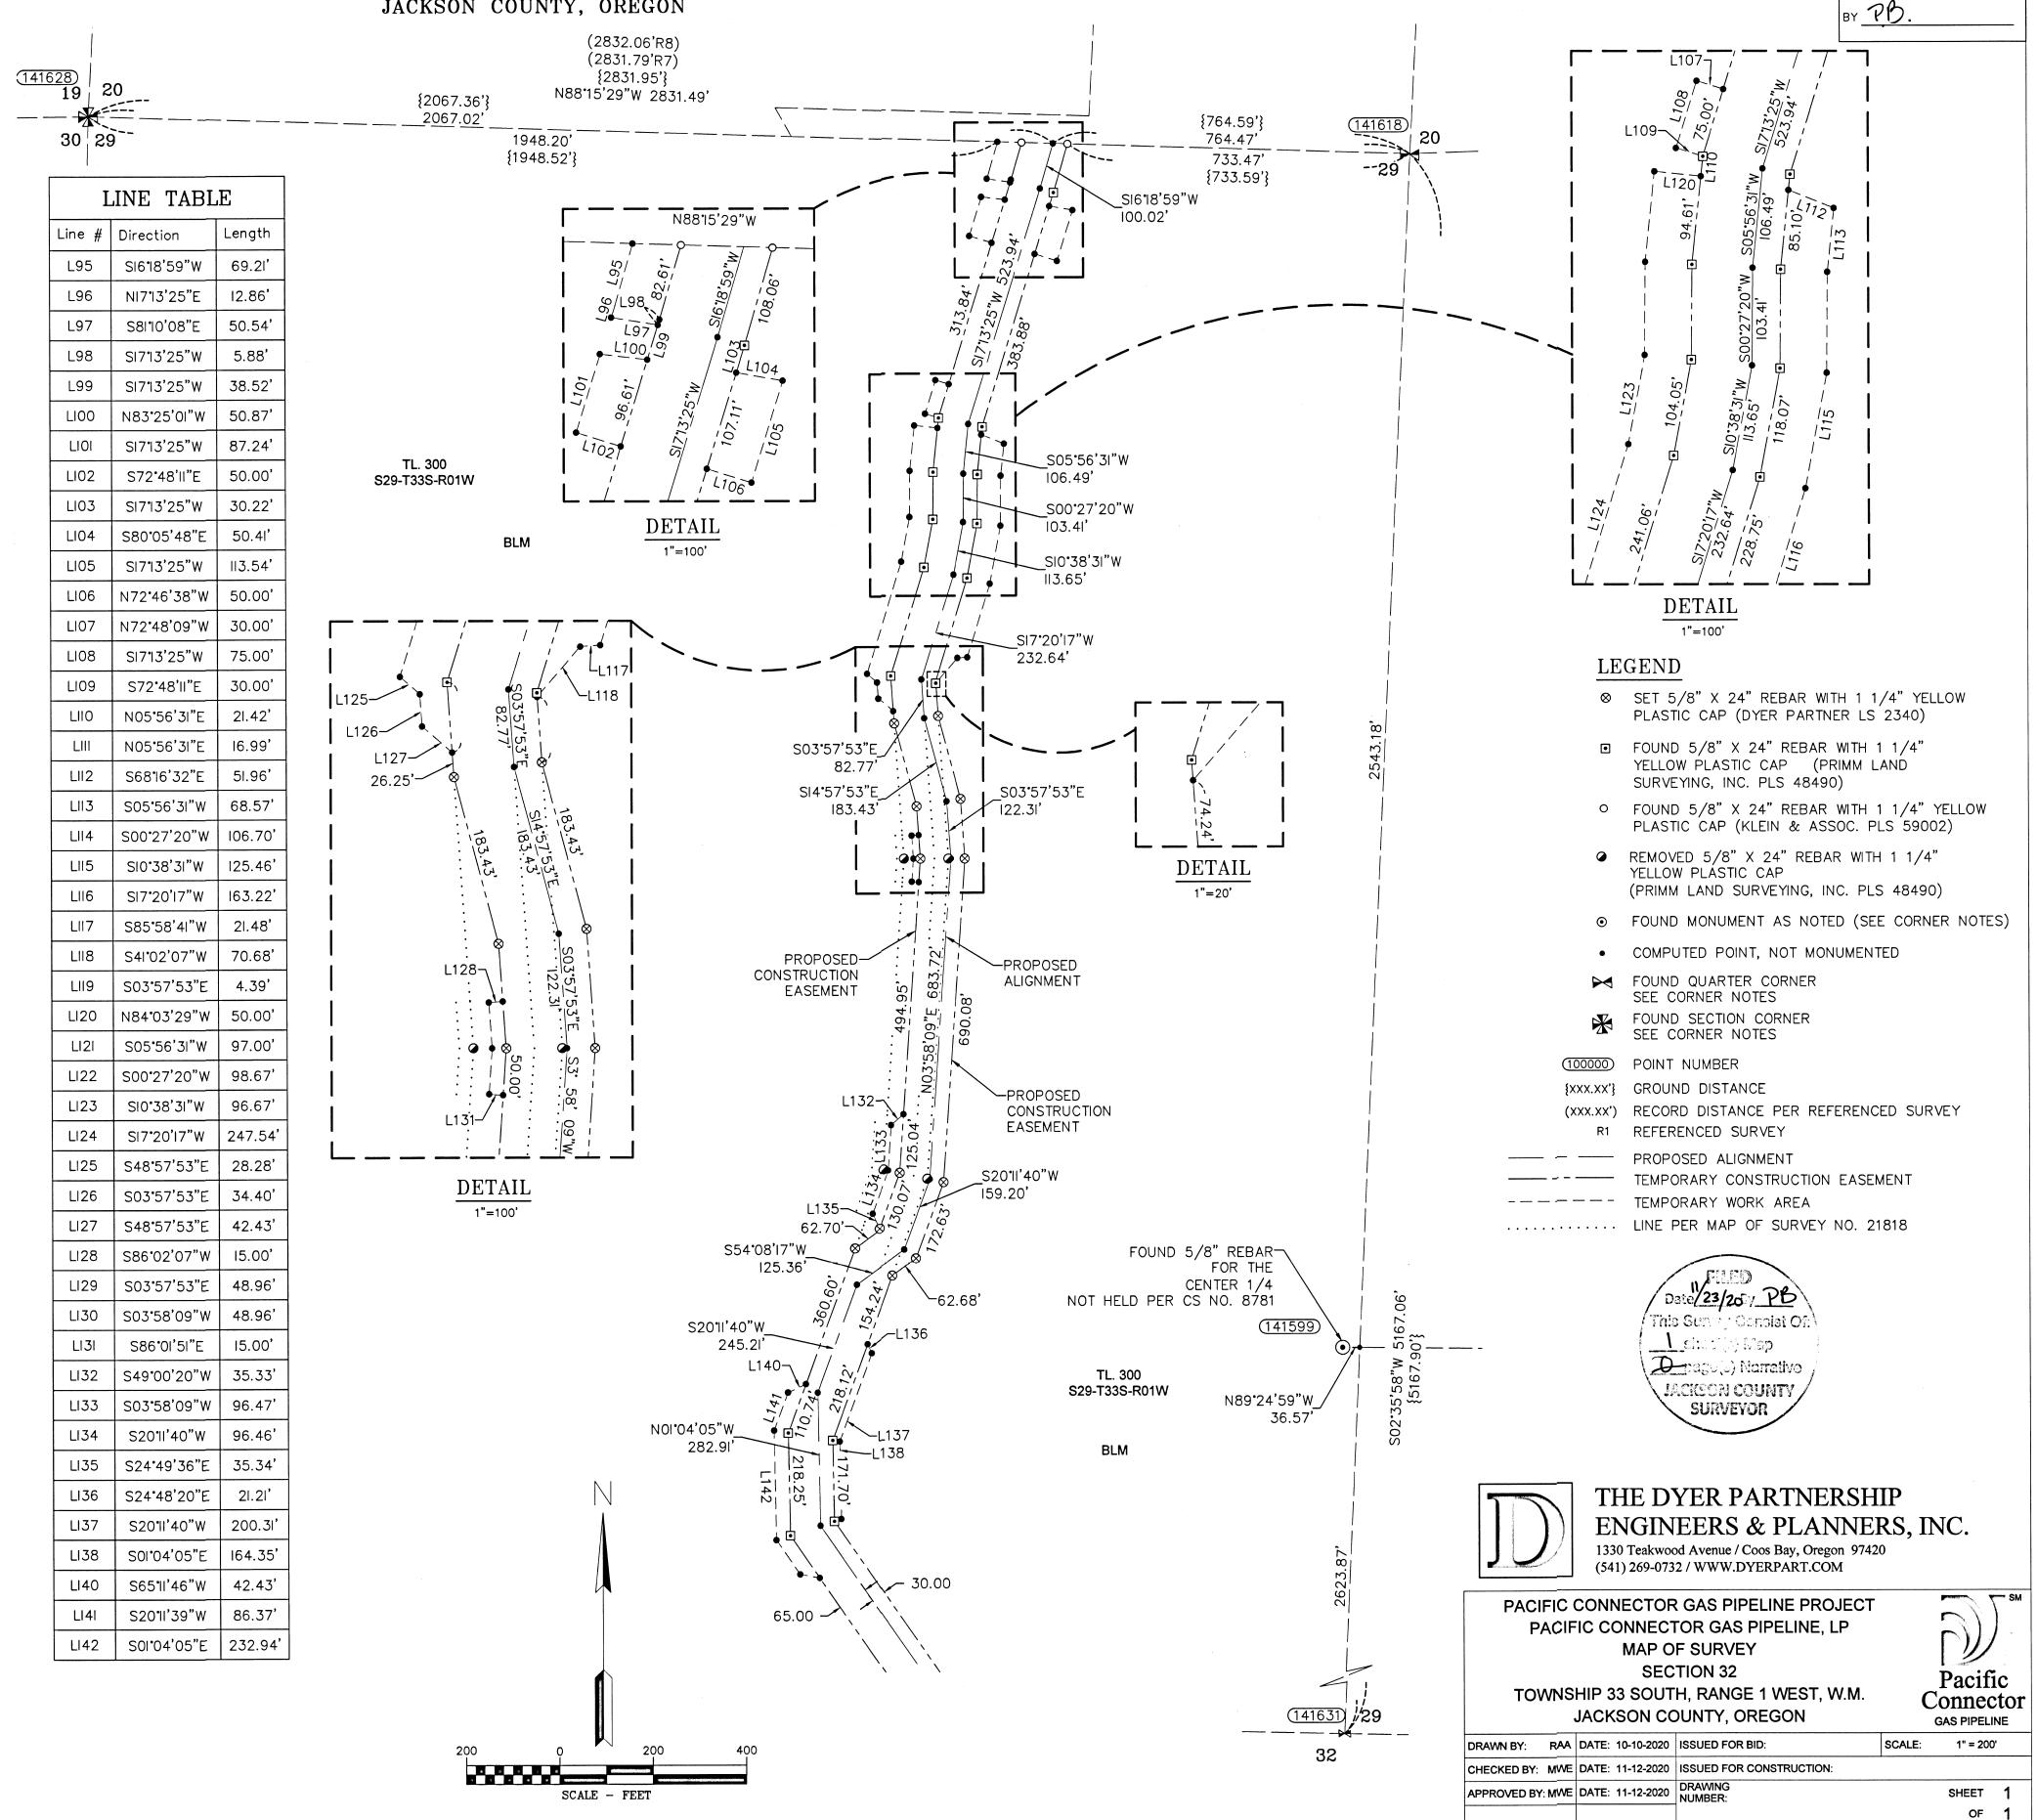

JACKSON COUNTY

SURVEYOR'S OFFICE

SURVEY NO. 23195

FILED 11/23/2020