

Survey For
 HERRIED REAL ESTATE
 Located in Lots 1 & 20, Block 2
 TIMMONS SUBDIVISION (recorded)
 Located in the SE 1/4 of Sec. 29, T36SRIW, W.M.
 By: Mark E. Boyden
 October 1963

Fd. Conc. Mon.
 Initial Point
 TIMMONS SUBD.

2320

LOTUS

LANE

S 89°40'30" E

315.00'
 plot & measured

108.00'

102.00'

102.00'

102.00'

102.00'

102.00'

102.00'

102.00'

315.00'

315.00'

315.00'

362.26'

60'

60.00'

108.00'

102.00'

102.00'

102.00'

102.00'

102.00'

102.00'

60.00'

DRIVE

plot & measured

1202.26

McLAUGHLIN


S 0°08' E

60'

N

SCALE: 1" = 100'

- Fd. 5/8" I. Pin
 orig. subd. cor.
- Set 5/8" I. Pin

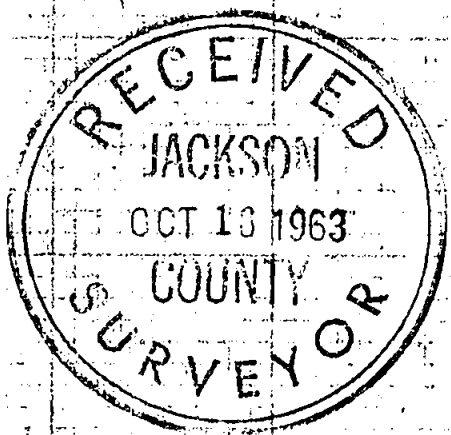

REGISTERED
 OREGON
 LAND SURVEYOR

Mark E. Boyden

NOVEMBER 9, 1951
 MARK E. BOYDEN
 281

2320

RANDALL

N 89°40'30" W
 AVE

Survey No. 2320

SURVEY NARRATIVE TO COMPLY WITH O.R.S. 209.250

FOR: Herried Real Estate
1 King Street
Medford, Oregon

LOCATION: Southeast 1/4 of Section 29, Township 36 South,
Range 1 West, Willamette Meridian.

PURPOSE: To re-subdivide Lots 1 & 20, Block 2 of
TIMMONS SUBDIVISION.


PROCEDURE:

Found subdivision control monuments as shown.

Re-measured the East boundary of the subdivision for distance
verification, and then set monuments as shown.

Basis on bearings: TIMMONS SUBDIVISION.

October 1963

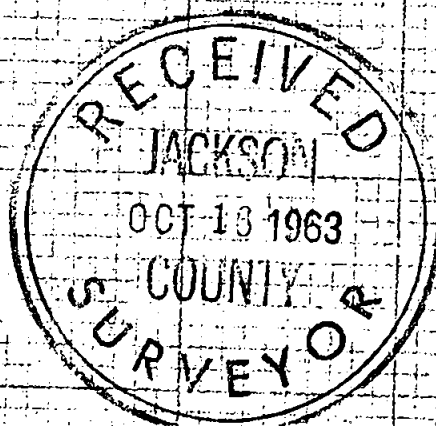

Mark E. Boyden

NOVEMBER 9, 1951
MARK E. BOYDEN

281