


RECORD OF MONUMENT PRESERVATION

LOCATED IN THE NORTHEAST 1/4 OF SECTION 19, TOWNSHIP
37 SOUTH, RANGE 1 WEST, WILLAMETTE MERIDIAN, IN THE
CITY OF MEDFORD, JACKSON COUNTY, OREGON


**** RECEIVED ****
DATE 11/23/20 BY MB
This survey consists of:
1 sheet(s) Map
0 page(s) Narrative
JACKSON COUNTY
SURVEYOR

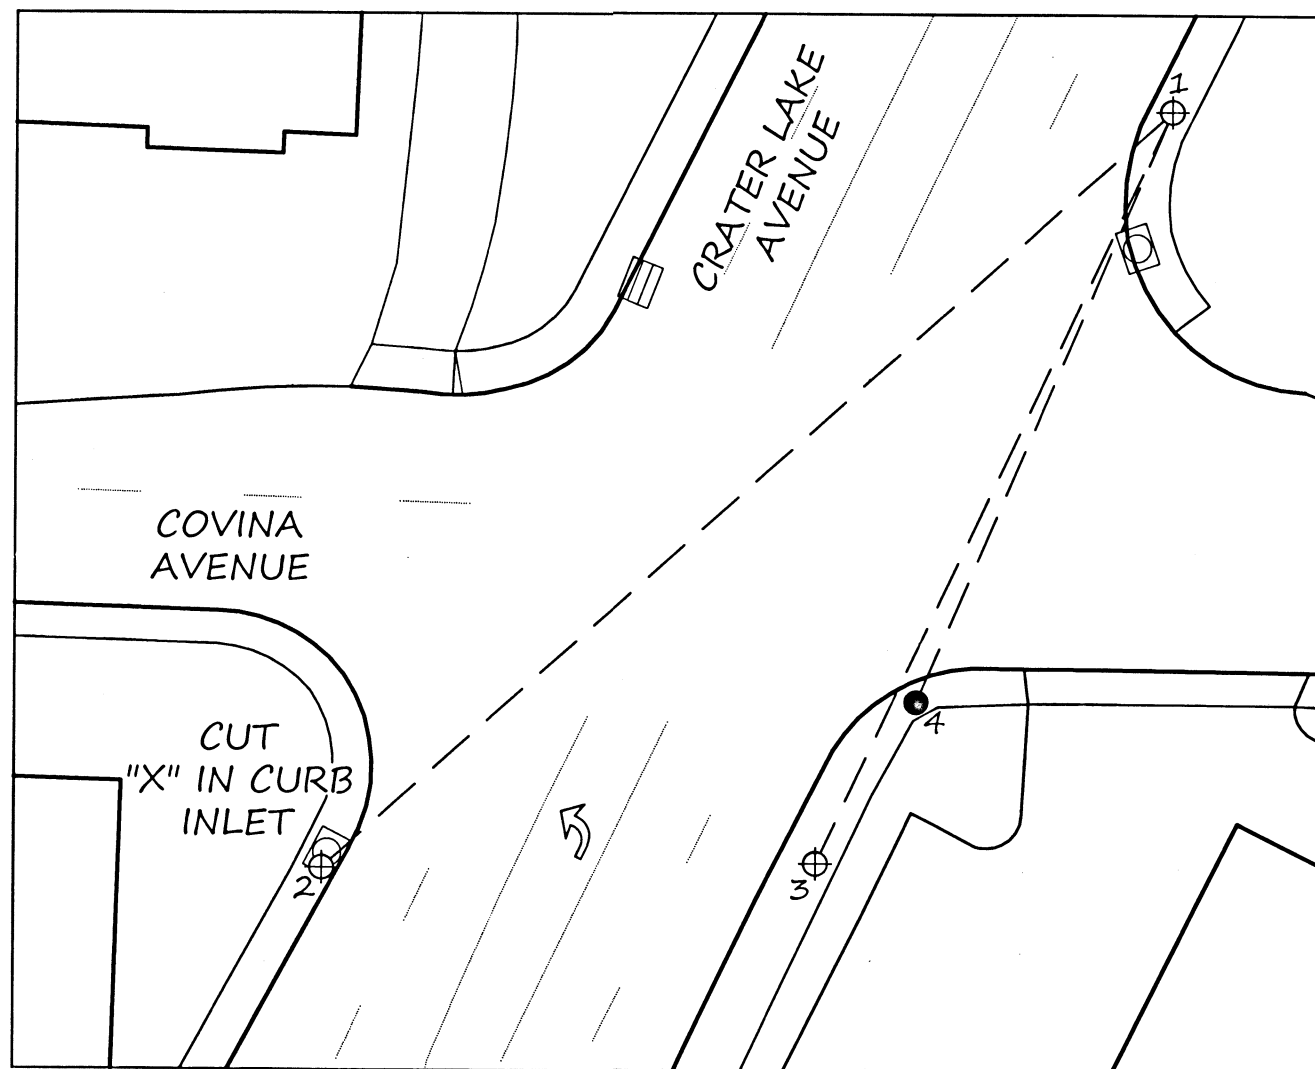

SET UP @ PNT 1
BACKSIGHT AT PNT 2

PNT	ANGLE RIGHT	HORIZ DIST.
2	00-00-00	177.91
3	337-01-18	130.40
4	335-05-00	100.89

- ⊗ FOUND CUT "X" IN SIDE WALK PER RECORD OF MONUMENT PRESERVATION NUMBER 23020
- SET 1" COPPER PLUG FLUSH IN CONCRETE MARKED "CITY OF MEDFORD" TO REPLACE LEAD PLUG & TACK WITH BRASS WASHER STAMPED "LS 2023" PER SURVEY 20102

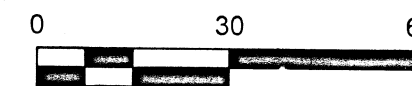

SCALE 1"=30'

SURVEY NARRATIVE TO COMPLY WITH O.R.S. 209.250

SURVEY FOR/BY: CITY OF MEDFORD, 411 WEST 8TH STREET, MEDFORD, OREGON 97501

DATE OF SURVEY: OCTOBER, 2020

PURPOSE: IN ACCORDANCE O.R.S. 209.150 THE PURPOSE OF THIS SURVEY IS TO RE-ESTABLISH THE LOCATION OF A FOUND MONUMENT (PER SN 20102) REPORTED IN RECORD OF MONUMENT PRESERVATION NUMBER 23020 THAT WAS DESTROYED BY CONCRETE RAMP RECONSTRUCTION. POINT #4 WAS PREVIOUSLY TIED IN SAID SURVEY AND IS NOW REPLACED WITH A 1" COPPER PLUG MARKED "CITY OF MEDFORD"

UTILIZING A TRIMBLE S6 ROBOTIC TOTAL STATION, CONTROL WAS SET AS SHOWN HEREON FOR THIS SURVEY. FROM SAID CONTROL REDUNDANT MEASUREMENTS WERE MADE AS SHOWN TO FOUND MONUMENTS PRIOR TO DESTRUCTION.

371W19AD TL501

REGISTERED
PROFESSIONAL
LAND SURVEYOR
[Signature] 11/20/20
OREGON
JANUARY 9, 2007
JON M. PROUD
77652
EXPIRES DECEMBER 31, 2020

CITY OF MEDFORD - SURVEYING DEPARTMENT			
CRATER LAKE AVENUE & COVINA AVENUE			
DRAWN BY: ZPE	DATE 10/20/2020	PROJECT NO.	N/A
CHECKED BY: JP	DATE 10/20/2020	SHEET NO.	1 OF 1
DATE REFERENCED:	DATE 10/16/2020		
CREW: Z. EARLE, S. METZGER			