


RECORD OF MONUMENT PRESERVATION

LOCATED IN THE NORTHEAST 1/4 OF SECTION 30, TOWNSHIP
37 SOUTH, RANGE 1 WEST, WILLAMETTE MERIDIAN, IN THE
CITY OF MEDFORD, JACKSON COUNTY, OREGON

**** RECEIVED ****
DATE 11/23/20 BY JPB
This survey consists of:
1 sheet(s) Map
4 page(s) Narrative
JACKSON COUNTY
SURVEYOR

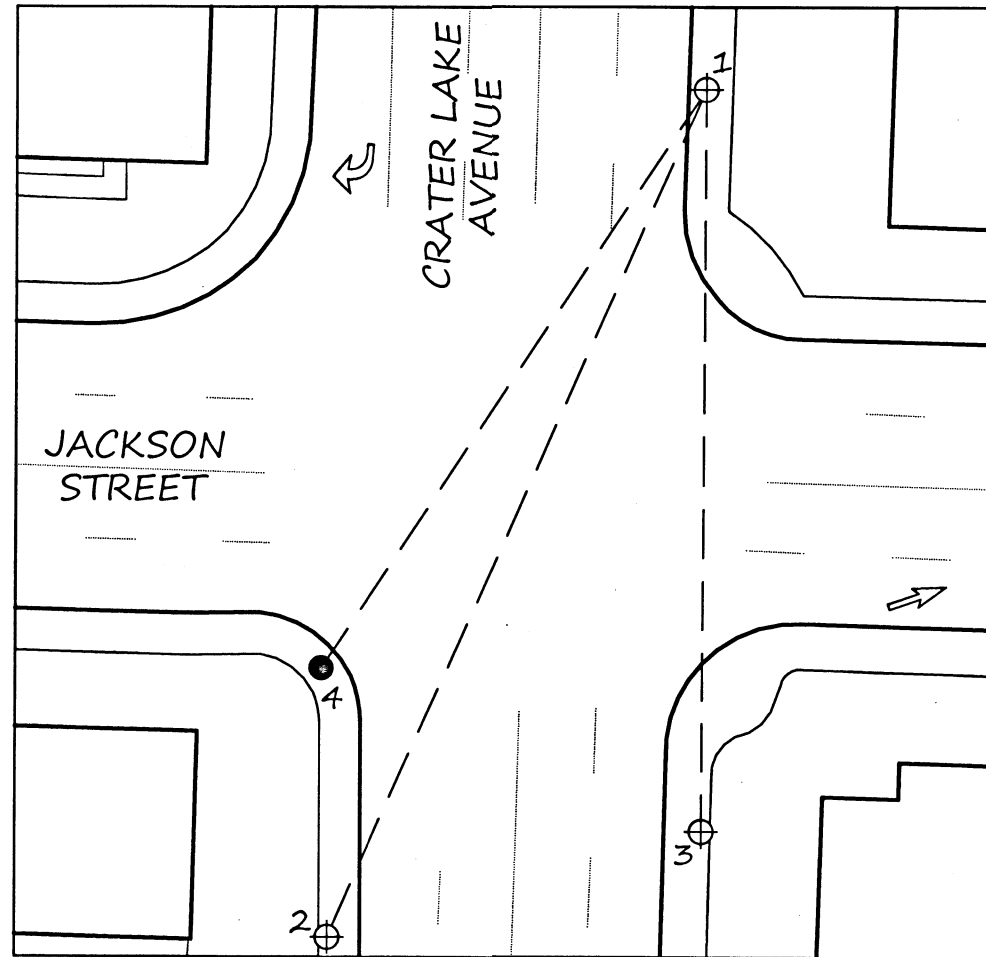


SET UP @ PNT 1
BACK SIGHT AT PNT 2

| PNT | ANGLE RIGHT | HORIZ DIST. |
|-----|-------------|-------------|
| 2 | 00-00-00 | 145.30 |
| 3 | 336-22-02 | 116.51 |
| 4 | 09-33-37 | 108.52 |

⊗ FOUND CUT "X" IN SIDE WALK PER RECORD OF MONUMENT PRESERVATION 23019

● SET 1" COPPER PLUG FLUSH IN CONCRETE MARKED "CITY OF MEDFORD" TO REPLACE LEAD AND TACK IN CONCRETE FOUND PER SURVEY 6232

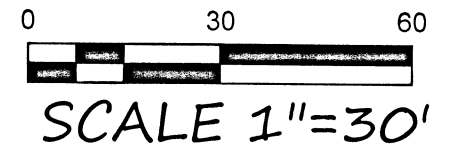

SURVEY NARRATIVE TO COMPLY WITH O.R.S. 209.250

SURVEY FOR/BY: CITY OF MEDFORD, 411 WEST 8TH STREET, MEDFORD, OREGON 97501

DATE OF SURVEY: OCTOBER, 2020

PURPOSE: IN ACCORDANCE O.R.S. 209.150 THE PURPOSE OF THIS SURVEY IS TO RE-ESTABLISH THE LOCATION OF A FOUND MONUMENT (PER SN 6232) REPORTED IN RECORD OF MONUMENT PRESERVATION NUMBER 23019 THAT WAS DESTROYED BY CONCRETE RAMP RECONSTRUCTION. POINT #4 WAS PREVIOUSLY TIED IN SAID SURVEY AND IS NOW REPLACED WITH A 1" COPPER PLUG MARKED "CITY OF MEDFORD"

EQUIPMENT USED TO PERFORM THIS SURVEY CONSISTED OF UTILIZING A TRIMBLE S6 ROBOTIC TOTAL STATION AND TSC3 DATA COLLECTOR.

REGISTERED
PROFESSIONAL
LAND SURVEYOR
[Signature]
OREGON
JANUARY 9, 2007
JON M. PROUD
77652
EXPIRES DECEMBER 31, 2020

| CITY OF MEDFORD - SURVEYING DEPARTMENT | | | |
|--|-----------------|-------------|--------|
| CRATER LAKE AVENUE & JACKSON STREET | | | |
| DRAWN BY: ZPE | DATE 10/20/2020 | PROJECT NO. | N/A |
| CHECKED BY: JP | DATE 10/20/2020 | SHEET NO. | 1 OF 1 |
| DATE REFERENCED: | DATE 10/16/20 | | |
| CREW: Z. EARLE, S. METZGER | | | |

371W30AB TL7600