


LINE TABLE		
LINE	BEARING	DISTANCE
L1	S89°50'48"E	134.05'
		[134.30']
L2	S89°50'48"E	29.99'
		[30.00']
L7	S00°09'12"W	30.00'

MONUMENT BEARS		
LINE	BEARING	DISTANCE
L3	N00°09'12"E	0.05'
L4	N00°09'12"E	0.17'
L5	N00°09'12"E	0.15'
L6	N00°09'12"E	0.14'

FILED
Date 4/5/21 By PB
This Survey Consist Of:
1 sheet(s) Map
0 page(s) Narrative
JACKSON COUNTY SURVEYOR

MAP OF SURVEY
LOCATED IN THE SOUTHWEST QUARTER OF SECTION 32, TOWNSHIP 36 SOUTH, RANGE 1 WEST OF THE WILLAMETTE MERIDIAN, JACKSON COUNTY OREGON.
MONUMENT REPLACEMENT FOR
FRED OWEN
3400 CRATER LAKE AVENUE
MEDFORD, OREGON 97504

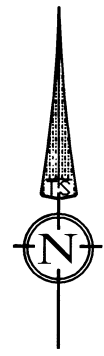

SCALE: 1" = 300'
DATE: 02-10-21

REGISTERED
PROFESSIONAL LAND SURVEYOR
Fred A. Frantz
OREGON
JULY 12, 2005
FRED A. FRANTZ
No. 50077

Renewal 12-31-21

- LEGEND:**
- S/N SURVEY NUMBER FILED AT THE JACKSON COUNTY SURVEYOR'S OFFICE.
 - RE-ESTAB JACKSON COUNTY GOVERNMENT CORNER RE-ESTABLISHMENT RECORDS.
 - FOUND MONUMENT PER S/N 2775 OR AS INDICATED.
 - FOUND MONUMENT PER S/N 2775, DESTROYED, REPLACED WITH 5/8" BY 24" IRON PIN WITH CAP MARKED 'FRANTZ LS50077'.
 - ① FOUND MONUMENT PER S/N 22634, DESTROYED, REPLACED WITH 5/8" BY 24" IRON PIN WITH CAP MARKED 'FRANTZ LS50077'.
 - () RECORD DATA PER S/N 2775 OR AS INDICATED.
 - [] RECORD DATA PER S/N 22634.
- BASIS OF BEARING IS DETERMINED BY HIGH ACCURACY GPS OBSERVATIONS NAD83 (2011) AS APPLIED TO THE FOUND MONUMENTS ON THE CENTER LINE OF VILAS ROAD AS SHOWN. SAID BEARING BEING S89°50'48" EAST.

SURVEY NARRATIVE TO COMPLY WITH O.R.S. 209.250

PURPOSE: TO TIE EXISTING FOUND MONUMENTS PER S/N'S 2775 AND 22634 FOR REPLACEMENT OF DISTURBED OR LOST MONUMENTS AFTER THE INSTALATION OF A NEW SANITARY SEWER LINE.

PROCEDURE: THE UTILIZING TRIMBLE R10 GPS RECIEVERS, I TIE THE FOUND MONUMENTS PER S/N'S 2775 AND 22634 AS SHOW AND REPLACE THEM AS FOUND AFTER COMPLETION OF CONSTRUCTION.

TERRASURVEY, INC.
PROFESSIONAL LAND SURVEYORS
274 FOURTH STREET
ASHLAND, OREGON 97520
(541) 482-6474
terrain@bisp.net
JOB NO. 1326-20