

SECTION 18, TOWNSHIP 33 SOUTH, RANGE 3 WEST, W.M.

T.33S. R.4W. SEC. 12 SEC. 13 SEC. 24 T.33S. R.4W.

T.33S. R.3W. SEC. 7 SEC. 18 SEC. 19 T.33S. R.3W.

CORNER OF SECTIONS 12, 7, 18, & 13 T.33S., R.3W. & R.4W.: MONUMENT STAMPED "T33S R4W R3W S12 S7 S13 S18 1968" PER R4, FROM WHICH BEARS: 44" DF WITH HB N65°E 33.7' F=R4. 35" IC WITH HB S61°W 44.9' F=R4. 19" WF WITH HB S42°E 34.3' F=R4. 15" DF WITH HB N89°W 22.1' F=R4.

SILVER BUTTE TIMBER CO. D.N. 97-28032 T.L. 1800

1/4 CORNER OF SECTIONS 7 & 18: MONUMENT STAMPED "T33S R3W 1/4 S7 S18 1966" PER R3, FROM WHICH BEARS: 28" IC WITH HB S56 1/2°E 13.9' F (S58°E R3). 35" DF WITH HB S36°W 44.9' F=R3. 8" DF SCRIBED XBT THIS SURVEY S56 1/2°W 12.2'. 11" MD SCRIBED XBT THIS SURVEY N58 1/2°E 17.0'.

MURPHY TIMBER INVESTMENTS, LLC D.N. 2014-032842 T.L. 1700

C1/4 CORNER OF SECTION 18: CAP STAMPED "T33S R3W C1/4 S18 2021 PLS 77662", FROM WHICH BEARS: 7" DF SCRIBED XBT N13 1/4°W 16.4'. 15" DF SCRIBED XBT S89 1/2°E 20.6'. 6" DF SCRIBED XBT S36 1/2°E 25.6'. 9" DF SCRIBED XBT N37 1/2°W 7.2'.

4847.6' R7) 4914.88' F

CORNER OF SECTIONS 7, 8, 17, & 18: MONUMENT STAMPED "T33S R3W S7 S8 S17 S18 1969" PER R2, FROM WHICH BEARS:

27" DF WITH HB N29°E 17.4' F (N33°E 17.8' R2). 53" YP WITH HB S46°E 14.5' F=R2. 32" DF WITH HB S57°W 54.8' F (54.1' R2). 29" DF WITH HB N54°W 22.1' F=R2.

FILED Date 4/1/21 By [Signature] This Survey Consist Of: 1 sheet(s) Map 0 page(s) Narrative JACKSON COUNTY SURVEYOR



LEGEND OF SYMBOLS & ABBREVIATIONS:

- FOUND STANDARD BLM MONUMENT (SEE NARRATIVE).
FOUND 5/8" REBAR PER R7, NO IDENTIFICATION.
SET 5/8" REBAR WITH 2 1/2" AC AS DESCRIBED.
AC ALUMINUM CAP BC BRASS CAP DF DOUGLAS FIR D.N. DOCUMENT NUMBER F FIELD MEASUREMENT GIP GALVANIZED IRON PIPE GLO GENERAL LAND OFFICE HB HEALED BLAZE HK HEMLOCK IC INCENSE CEDAR I.D. INSIDE DIAMETER LO LIVE OAK O.D. OUTSIDE DIAMETER MD MADRONE VS VISIBLE SCRIBING WF WHITE FIR YP YELLOW PINE () RECORD DATA

REFERENCES:

- R1 = GLO PLAT FOR T.33S., R.3W., W.M. APPROVED MARCH 1885.
R2 = BLM PLAT & NOTES FOR T.33S., R.3W., W.M. ACCEPTED AUGUST 16, 1971.
R3 = BLM NOTES FOR 1966 CORNER REMONUMENTATIONS BY JOSEPH S. GAWRON.
R4 = BLM NOTES FOR 1968 CORNER REMONUMENTATIONS BY JOHN M. JELLEY.
R5 = CS FIRST REESTABLISHMENT FOR THE CORNER OF SECTIONS 13, 18, 24, & 19, T.33S., R.3W. & R.4W., W.M.
R6 = CS FIRST REESTABLISHMENT FOR THE 1/4 CORNER OF SECTIONS 17 & 18, T.33S., R.3W., W.M.
R7 = BLM PLAT FOR 1977 ADMINISTRATIVE SURVEY BY GORDON L. CASTER., DATED SEPT. & OCT. 1977.

REGISTERED PROFESSIONAL LAND SURVEYOR [Signature] OREGON JULY 11, 2006 GREGG ARNOLD NEITSCH 77662LS EXPIRES: 12/31/2022

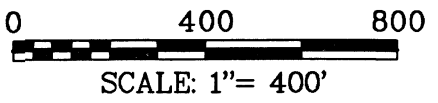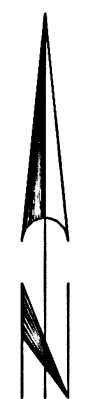

SURVEY NARRATIVE:

THE PURPOSE OF THIS SURVEY IS TO BLAZE AND TAG THE LINES SHOWN IN BOLD HEREON. LINE TREES AND TREES ON NON-MURPHY SIDE OF THE BOLD LINES WERE BLAZED THIS SURVEY. TREES ON MURPHY SIDE OF LINE WERE TAGGED. I RETRACED THE LINES BETWEEN THE FOUND MONUMENTS AS SHOWN IN ORDER TO SUBDIVIDE SECTION 18 PER THE 2009 BLM MANUAL OF SURVEYING INSTRUCTIONS AND DELINEATE THE BOUNDARIES BETWEEN LANDS DESCRIBED IN DEEDS FOR TAX LOTS 1700, 1800, & 600 (D.N. 2014-032842, D.N. 97-28032, & PUBLIC DOMAIN). THIS SURVEY WAS CONDUCTED USING A TOPCON GTS 3003W TOTAL STATION AND TOPCON HIPER GPS RECEIVERS. THE FIELD SURVEY COMMENCED MARCH 25, 2021 AND WAS COMPLETED APRIL 16, 2021. THE BASIS OF BEARINGS FOR THIS SURVEY IS GEODETIC (NAD83), AT THE 1/4 CORNER OF SECTIONS 18 AND 19 SHOWN HEREON, BASED ON STATIC GPS OBSERVATIONS TO CONTINUOUSLY OPERATING REFERENCE STATIONS (EPOCH 2011). ALL FIELD BEARINGS AND DISTANCES TO BEARING TREES ARE TO THE CENTER OF THE TREE AT THE GROUND. A STANDARD BLM MONUMENT IS A 2 1/2" O.D. GIP WITH 3 1/4" DIAM. BC.

MAP OF SURVEY

FOR MURPHY TIMBER INVESTMENTS, LLC LOCATED IN THE NORTHEAST QUARTER OF SECTION 18, T. 33 S., R. 3 W., W.M., JACKSON COUNTY, OREGON

NORTH STATE LAND SURVEYING 1511 KYLYNN CT. MOUNT SHASTA, CA

APRIL 2021 SCALE: 1"=400' SHEET 1 OF 1 MEBGEOD.ASC MEBMOS.GXD JOB NO. 670