


RECORD OF MONUMENT PRESERVATION

LOCATED IN THE NORTHEAST 1/4 OF SECTION 25, TOWNSHIP
37 SOUTH, RANGE 2 WEST, WILLAMETTE MERIDIAN, IN THE
CITY OF MEDFORD, JACKSON COUNTY, OREGON


**** RECEIVED ****
DATE 6/1/21 BY JB
This survey consists of:
1 sheet(s) Map
0 page(s) Narrative
JACKSON COUNTY
SURVEYOR

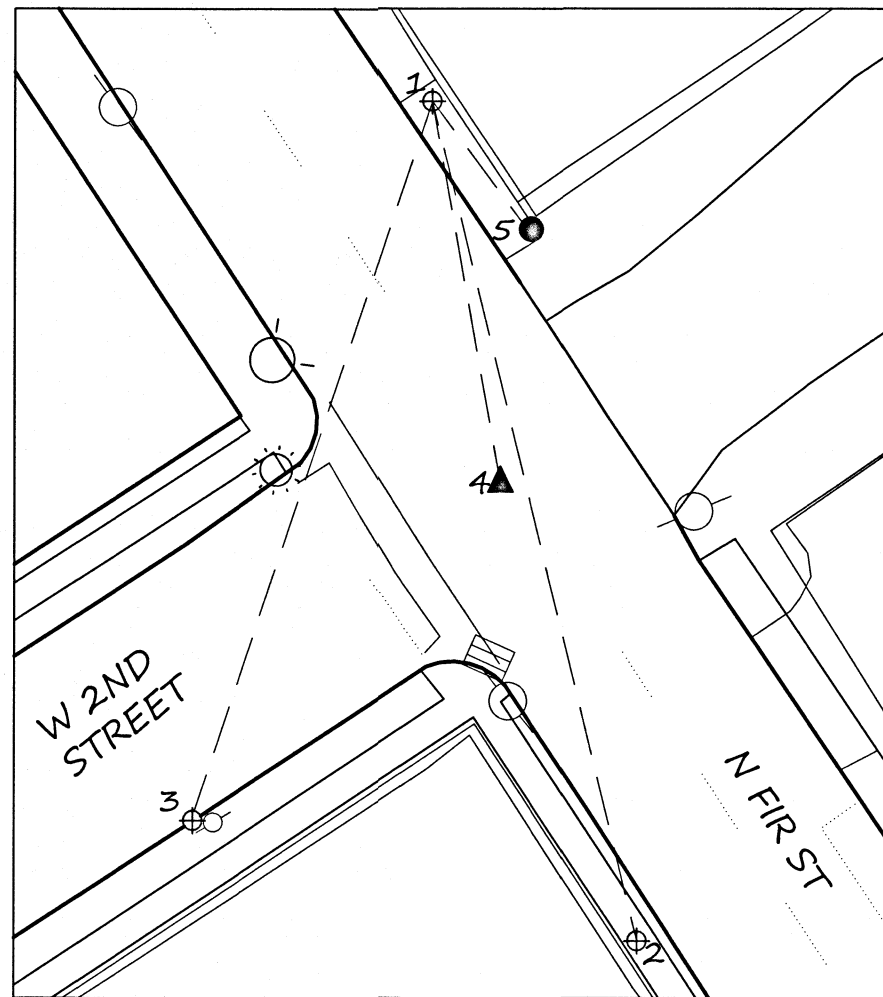

SET UP @ PNT 1
BACK SIGHT AT PNT 2

PNT	ANGLE RIGHT	HORIZ DIST.
2	00-00-00	135.11
3	32-14-39	118.20
4	03-36-35	60.54
5	337-09-11	26.03

- ⊗ SET CUT "X" IN CONCRETE
- FOUND 1" COPPER PLUG FLUSH IN CONC MARKED "MADDUX LS 2340" PER SN 23030
- ▲ FOUND BRASS CAP MARKED "1644" IN CONC PER COM FB 1635 PAGE 13

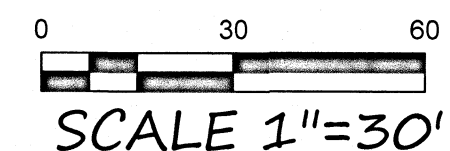

SURVEY NARRATIVE TO COMPLY WITH O.R.S. 209.250

SURVEY FOR/BY: CITY OF MEDFORD, 411 WEST 8TH STREET, MEDFORD, OREGON 97501

DATE OF SURVEY: DECEMBER 2020

PURPOSE: IN ACCORDANCE WITH O.R.S. 209.150 THE PURPOSE OF THIS SURVEY IS TO PERPETUATE EXISTING MONUMENTATION FROM FILED SURVEY 23030, AND FIELD BOOK 1635 PAGE 13 AT THE INTERSECTION OF FIR STREET AND 2ND STREET PRIOR TO CONCRETE RAMP RECONSTRUCTION AND ROAD ASPHALT OVERLAYS.

UTILIZING A TRIMBLE S6 ROBOTIC TOTAL STATION, CONTROL WAS SET AS SHOWN HEREON FOR THIS SURVEY. FROM SAID CONTROL REDUNDANT MEASUREMENTS WERE MADE AS SHOWN TO FOUND MONUMENTS PRIOR TO DESTRUCTION.

REGISTERED
PROFESSIONAL
LAND SURVEYOR

JB 5/28/21

OREGON
JANUARY 9, 2007
JON M. PROUD
77652
EXPIRES DECEMBER 2022

CITY OF MEDFORD - SURVEYING DEPARTMENT

N FIR STREET AND W 2ND STREET

DRAWN BY: ZPE	DATE 5/7/2021	PROJECT NO. N/A
CHECKED BY: JP	DATE 5/7/2021	
DATE REFERENCED:	DATE 12/14/2020	SHEET NO. 1 OF 1
CREW: Z. EARLE, S. METZGER		

372W25AA