

## SURVEY NARRATIVE TO COMPLY WITH PARAGRAPH 209.250, OREGON REVISED STATUTES

FOR: ELK LUMBER COMPANY

PURPOSE: To rehabilitate and perpetuate the Section corner common to Sections 15, 16, 21 and 22, Township 33 South, Range 1 East, W.M.

## PROCEDURE:

Found all four of the original B.T.'s all of which are in poor condition: The original Southwest BT is a dead 12 inch Black Oak stub with scribe recently exposed. The original Northwest BT is a dead and down Black Oak with ~~all~~ faces discernable but with all scribing obliterated by decay. The original Northeast BT is a live 16.5 inch White Oak decayed in the heart, which we reopened and exposed scribing.

The original Southeast BT is a hollow White Oak stub with scribing destroyed by decay but showing faint reversed scribing within callus outline of old face.

All these original trees agree well with the record for both bearing and distance.

At the corner point as determined from the original BT's I set a 1 inch by 36 inch galvanized steel pipe driven 6 inches into the ground to bedrock and surrounded by a mound of stone 16 inches high and with a 30 inch base. The pipe is capped with a 1-1/2 inch to 1 inch galvanized bell reducer filled with pot metal and stamped as shown below in 1/8 inch letters and numerals:

1963  
T 33 S R 1 E


16 15  
*Row* 23 22  
21  
SEC COR  
RS 583

From this monument a 9.5 inch Douglas fir bears North 15° 00' East 15.95 feet to face of lower blaze; a 12.0 inch Douglas fir bears North 10° 00' West 23.2 feet to face of upper blaze; an 11.0 inch Douglas fir bears South 61° 30' West 8.1 feet to face of upper blaze and a 9.0 inch Black Oak bears South 24° 00' East 43.45 feet to face of lower blaze. All the new BT's described above are double blazed and scribed "RS 583" in the upper blaze and "BT" in the lower.

Compass variation set at 20° 00'.

Field work by Robert M. Vincent and John Flanagan.

October 29, 1963

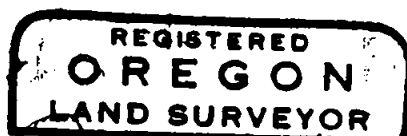

*Robert M. Vincent*  
JULY 9, 1962  
ROBERT M. VINCENT  
583

