

# CORNER INVESTIGATION REPORT

FS INDEX ID: N/A

CORNER: AP 8, LOT 5      GCDB ID: N/A      DATE: 1/26/21  
TOWNSHIP: 40S      STATE: OREGON  
RANGE: 3W      COUNTY: JACKSON  
SECTION: 18      FOREST: ROGUE RIVER-SISKIYOU NF  
MERIDIAN: WILLAMETTE      DISTRICT: SISKIYOU MOUNTAINS RD  
NFSL PROPERTY BOUNDARY CORNER?:     YES     NO

HISTORY OF VISITATIONS:

LINE(S) POSTED:  
MAINTAINED:    NORTH-2020    SOUTH-2020  
GUARD POST(S):    NORTH            SOUTH  
CORNER HISTORY:  
 SET BY BLM IN 1991 BY STEPHEN L. BAROTT

**REGISTERED  
PROFESSIONAL  
LAND SURVEYOR**

*Jason M. Martin*  
 OREGON  
 MAY 8, 2012  
 JASON M. MARTIN  
 54729

RENEWS: 1-1-2023

MONUMENT FOUND/SET:  
 3 1/2" BRASS CAP ON 2 1/2" PIPE, APPROX. 0.1' EXPOSED, IN SMALL PILE OF STONES. GOOD CONDITION

RECORD MEASUREMENTS:

BEARS S88 1/2°E, 49lks, (32.3')  
 BEARS N21 3/4°W, 74lks, (48.8')


BEARS S80°W, 35.2'

METHOD OF MEASUREMENT:

RECORD CORNER ACCESSORIES:

PER BLM FIELD NOTES 1991  
 10" DIA PINE (NOW STANDING DEAD)  
 8"DIA OAK (NOW 12") HEALED BLAZES

FOUND  
 11" DIA OAK, LOWER SCRIBE VISIBLE "BT"  
 JACKSON COUNTY SURVEYOR TAG  
 NO RECORD

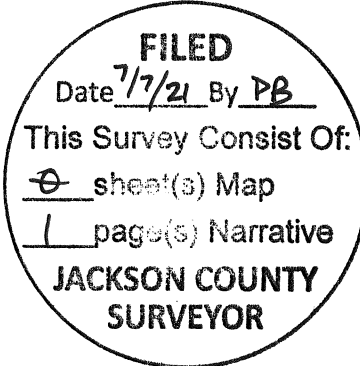

NEW CORNER ACCESSORIES:

NO NEW ACCESSORIES ESTABLISHED

CORNER MAINTENANCE/OTHER INFO:

CLEAR BRUSH FROM AROUND MONUMENT & TO BT'S. BT FACES & A 6" BAND AT HEAD HEIGHT PAINTED RED. ADD NEW NAILS TO BT TAGS & ADD NEW TAGS WHERE NEEDED. MONUMENT SIZES ARE OUTSIDE DIAMETER & BT DIAMETERS ARE AT BREAST HEIGHT.

GEODETTIC COORDINATES:

LATITUDE: N 42°05'10.6"  
 LONGITUDE: W 123°06'09.8"  
 ELLIPSOID HEIGHT: ~1783'  
 DATUM: WGS-84

DOCUMENTS ON FILE AT:

SOURCE: CONSUMER GRADE G.P.S.

DATE OF INVESTIGATION: 12/24/20

REPORT BY: JASON MARTIN

FIELD CREW: DENNIS H. MORTON, PARTY CHIEF  
 TOM MILSTEAD, FIELD TECH  
 RYAN BEIL, FIELD TECH

THIS DOCUMENT FILED IN CS OFFICE:

OTHER DOCUMENT FILED WITH CS:

CAP DIAGRAM:

