

CORNER INVESTIGATION REPORT

FS INDEX ID: N/A

CORNER: AP 9, LOT 5 GCDB ID: N/A DATE: 1/26/21
TOWNSHIP: 40S STATE: OREGON
RANGE: 3W COUNTY: JACKSON
SECTION: 18 FOREST: ROGUE RIVER-SISKIYOU NF
MERIDIAN: WILLAMETTE DISTRICT: SISKIYOU MOUNTAINS RD
NFSL PROPERTY BOUNDARY CORNER?: YES NO

HISTORY OF VISITATIONS:

**REGISTERED
PROFESSIONAL
LAND SURVEYOR**

Jason M. Martin
**OREGON
MAY 8, 2012
JASON M. MARTIN
54729**

RENEWS: 1-1-2023


LINE(S) POSTED:
MAINTAINED: W'LY-2020 SOUTH-2020
GUARD POST(S): W'LY SOUTH
CORNER HISTORY:
 SET BY BLM IN 1991, BY STEPHEN L. BAROTT

MONUMENT FOUND/SET:
 3 1/2" BRASS CAP ON 2 1/2" PIPE, APPROX. 0.4' EXPOSED, NO STONES,
 S'LY SIDE OF CAP SHOWS SLIGHT DAMAGE, OTHERWISE GOOD CONDITION

RECORD MEASUREMENTS:

RECORD CORNER ACCESSORIES:
 PER BLM FIELD NOTES 1991
 18" DIA FIR (NOW 25") HEALED BLAZE
 15" DIA OAK (NOW 16") HEALED BLAZE

BEARS N87 1/2°W, 26 1/2lks. (17.5')
 BEARS S17 1/2°W, 94lks. (62')

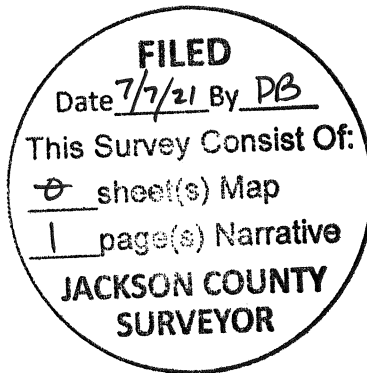

NEW CORNER ACCESSORIES:
 NO NEW ACCESSORIES ESTABLISHED

METHOD OF MEASUREMENT:

CORNER MAINTENANCE/OTHER INFO:
 CLEAR BRUSH FROM AROUND MONUMENT & TO BT'S. BT FACES & A 6" BAND AT
 HEAD HEIGHT PAINTED RED. ADD NEW NAILS TO BT TAGS & ADD NEW TAGS
 WHERE NEEDED. MONUMENT SIZES ARE OUTSIDE DIAMETER & BT DIAMETERS
 ARE AT BREAST HEIGHT.

CAP DIAGRAM:



GEODETTIC COORDINATES:
LATITUDE: N 42°05'07.7"
LONGITUDE: W 123°06'09.7"
ELLIPSOID HEIGHT: ~1859'
DATUM: WGS-84
SOURCE: CONSUMER GRADE G.P.S.
DATE OF INVESTIGATION: 12/24/20
REPORT BY: JASON MARTIN

DOCUMENTS ON FILE AT:

FIELD CREW: DENNIS H. MORTON, PARTY CHIEF
 TOM MILSTEAD, FIELD TECH
 RYAN BEIL, FIELD TECH

THIS DOCUMENT FILED IN CS OFFICE:
OTHER DOCUMENT FILED WITH CS: